

ADDENDUM NO. 2

DATE: July 3, 2025

Project: Glenview Public Library
Café Renovation

Architect: Studio GC architecture + interiors
223 W. Jackson Blvd. Suite 1200
Chicago, Illinois 60606

Project No.: 25007

1.1 SUMMARY

- A. The Bidding Documents and Project Manual dated June 16, 2025 and Drawings dated June 16, 2025 for the above referenced project are hereby modified and revised as follows.
- B. The information contained within this Addendum modifies, supplements or replaces information contained in the Project Manual and the Contract Drawings and is hereby made a part of the Contract Documents.
- C. Acknowledge receipt of this Addendum on the Bid Form. FAILURE TO DO SO MAY SUBJECT THE BIDDER TO DISQUALIFICATION.
- D. The Bidding Documents include the Project Manual dated June 16, 2025, the Drawings dated June 16, 2025, and Addenda issued prior to the receipt of bids.

1.2 PROJECT MANUAL

- A. None

1.3 DRAWINGS

- A. Sheet G1.00 – Code Compliance – First Floor
 - 1. Replace this sheet in its entirety.
- B. Sheet G3.00 – First Floor Reference Plan
 - 1. Replace this sheet in its entirety.
- C. Sheet E1.00 – Demolition and New Work Electrical and Lighting Plans
 - 1. Replace this sheet in its entirety.
- D. Sheet E2.01 – Electrical Notes, Details, and Schedules
 - 1. Replace this sheet in its entirety.

1.4 CLARIFICATIONS


A. None

End Addendum 009113.1

This Addendum consists of 2 pages.

Attachments:

- Project Manual: None
- Drawings: G1.00, G3.00, E1.00, E2.01

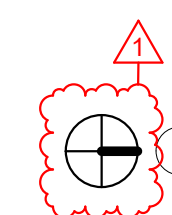

FIRST FLOOR - NEW FLOOR PLAN - GENERAL REFERENCE - PHASING
1" = 10'-0"

Glenview Public Library

Glenview Public Library
1930 Glenview Rd, Glenview, IL 60025

[illegible]

FIRST FLOOR REFERENCE PLAN

G3.00

25007



223 West Jackson Boulevard, Suite 1200
Chicago, Illinois 60606
(312) 253-3400

Glenview Public Library
1930 Glenview Rd Glenview IL 60025

1930 Glenview Rd Glenview IL 60025


- 1 PROVIDE GFCI TYPE CIRCUIT BREAKER (REPLACE EXISTING) FOR CIRCUIT SERVING VENDING MACHINES. MATCH EXISTING MANUFACTURER AND AIC RATING (SIEMENS, 65,000, V.I.F.)
- 2 WALL HEATER TOGGLE SWITCH MOUNTED IN CASE WORK. DISCONNECT AND REINSTALL NEW IN SAME WORK; VERIFY NEW LOCATION WITH ARCHITECT, VERIFY REQUIREMENTS IN FIELD.
- 3 VERIFY RECEPTACLE LOCATION FOR APPLIANCE WITH ARCHITECT PRIOR TO ROUGH-IN.
- 4 CONDUCTORS TO BE REUSED FOR NEW SCONCES IN NEARBY LOCATION. REMOVE LIGHT FIXTURES, PULL BACK WIRING, AND REMOVE CONDUIT AS REQUIRED TO ACCOMMODATE RENOVATIONS.
- 5 RECONNECT LIGHTING AND CONTROLS PREVIOUSLY SERVING REMODELED LIGHTING IN THIS SPACE. EXTEND/MODIFY RACEWAY AND CONDUCTORS AS REQUIRED.
- 6 DISCONNECT SECURITY CAMERA AND REINSTALL/RECONNECT CAMERA OFFSET FROM ORIGINAL POSITION TO ACCOMMODATE RENOVATIONS. PROVIDE LABOR, MATERIALS, CONDUIT AND BACKBOX AS REQUIRED. REFER TO ARCHITECTURAL PLANS FOR EXACT NEW LOCATION.
- 7 TEMPORARILY REMOVE THEN REINSTALL SECURITY CAMERA AND DOWNLIGHTS IN SAME LOCATION TO ACCOMMODATE RENOVATIONS.
- 8 PROVIDE NEMA 1-450R RECEPTACLE WITH 3 #6, 1 #10G IN 3/4" CONDUIT CONNECTION. REMOVE 2 SPARE CIRCUIT BREAKERS IN SPACES INDICATED AND TURN OVER TO OWNER. PROVIDE 50/20P CIRCUIT BREAKER MATCHING EXISTING MANUFACTURER AND AIC RATING (SIEMENS, 65,000 V.I.F.) VERIFY NEMA RECEPTACLE TYPE AND CIRCUIT BREAKER SIZE WITH OWNER. PROVIDED EQUIPMENT MANUFACTURER REQUIREMENTS.

[illegible]


E1.00

25007


COPYRIGHT 2024, STUDIO CC, INC.

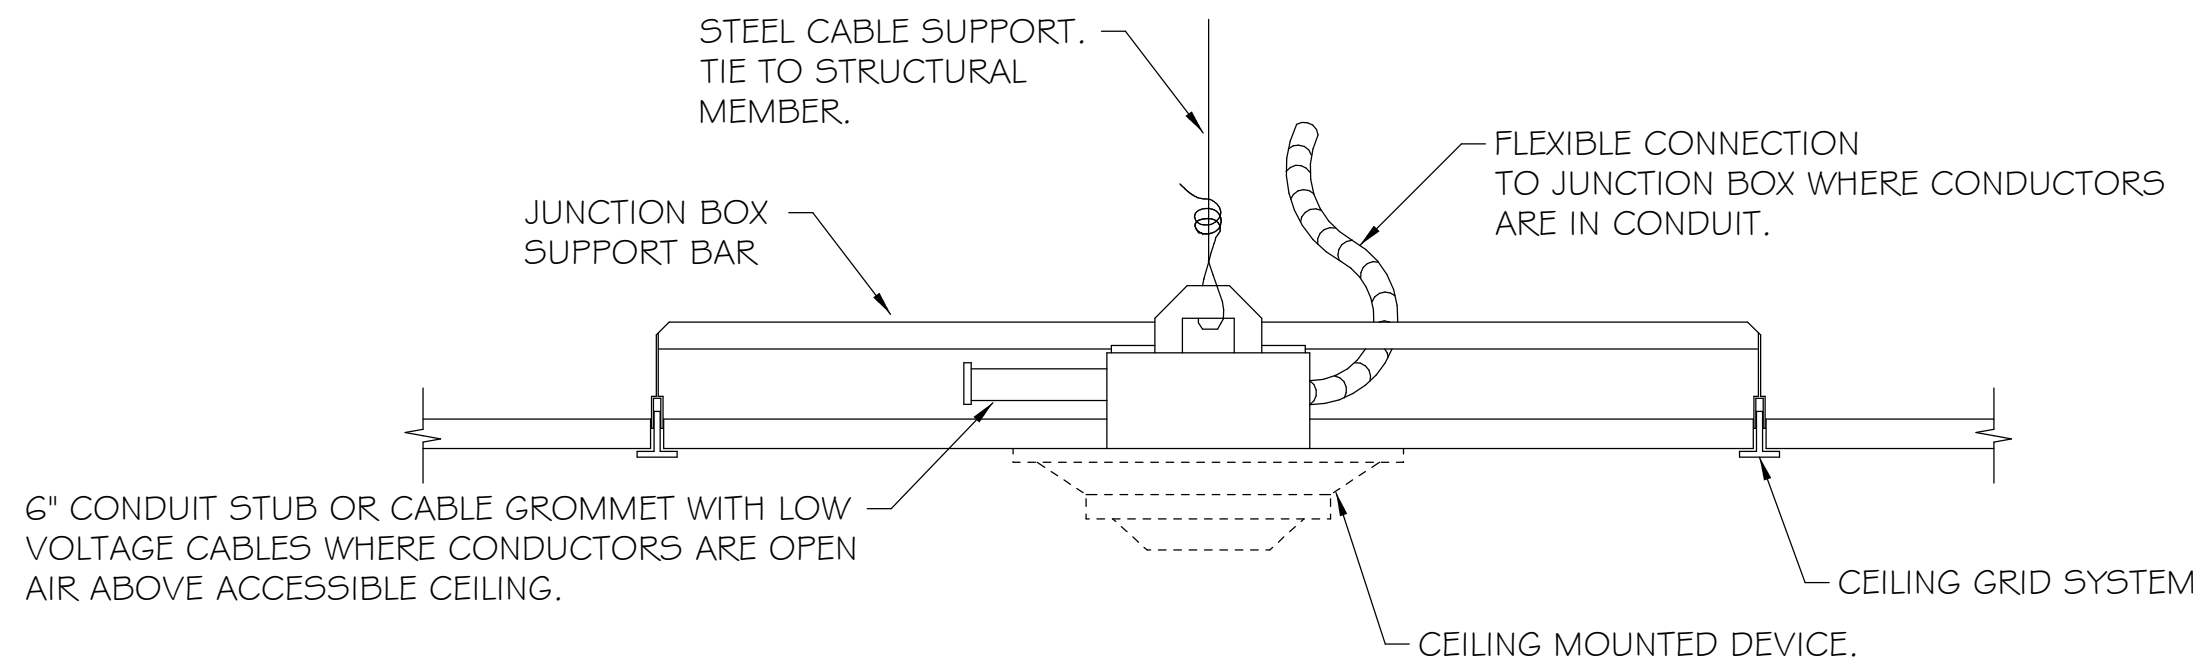


CEILING MOUNTED DEVICE SUPPORT DETAIL
NO SCALE

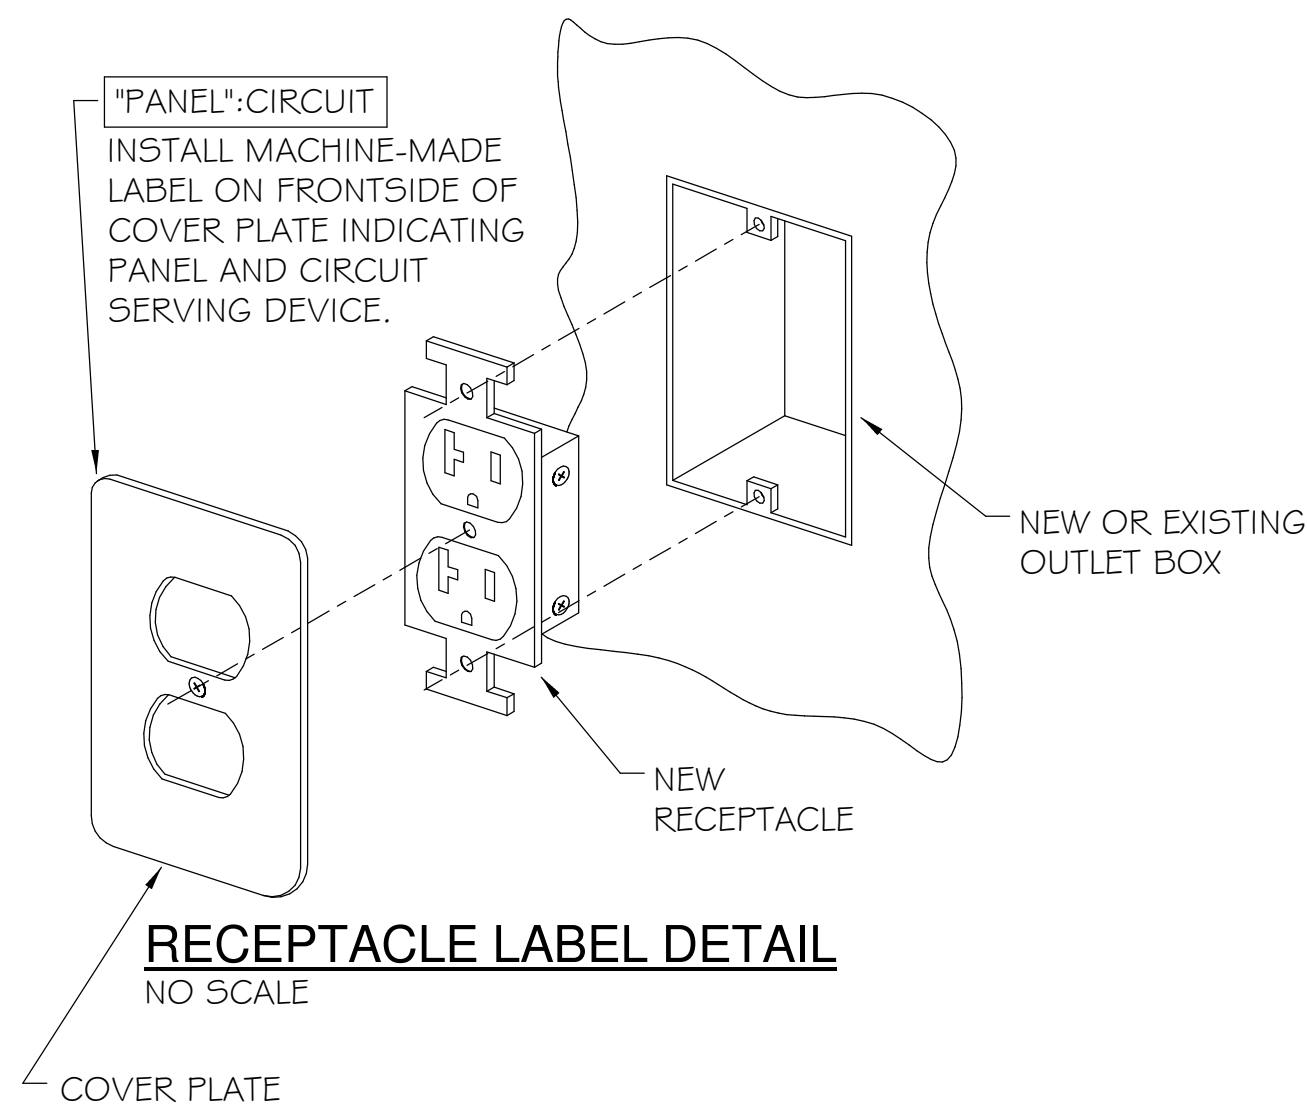

RECEPTACLE LABEL DETAIL
NO SCALE

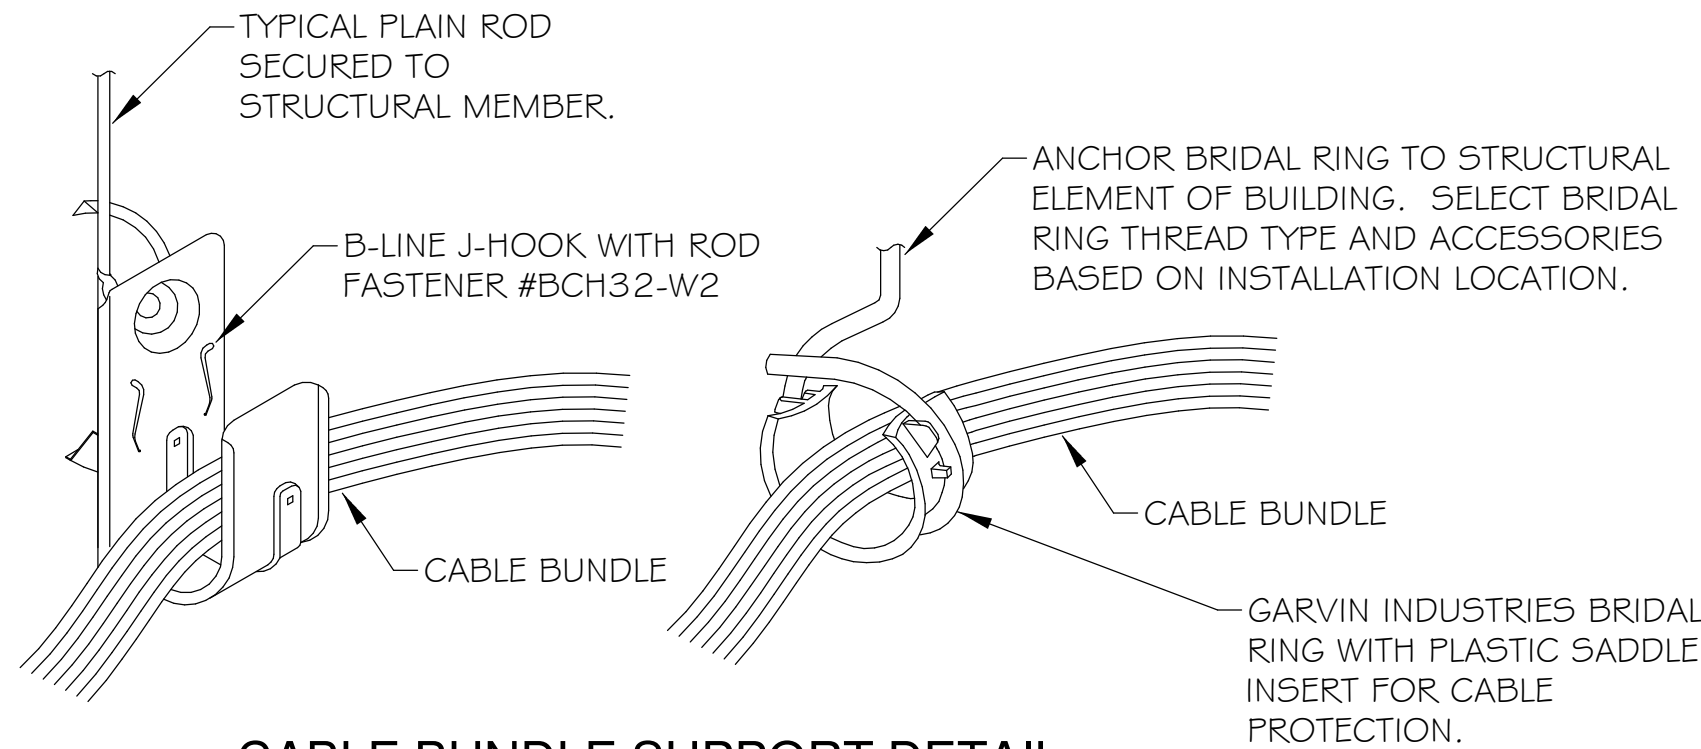

CABLE BUNDLE SUPPORT DETAIL
NO SCALE

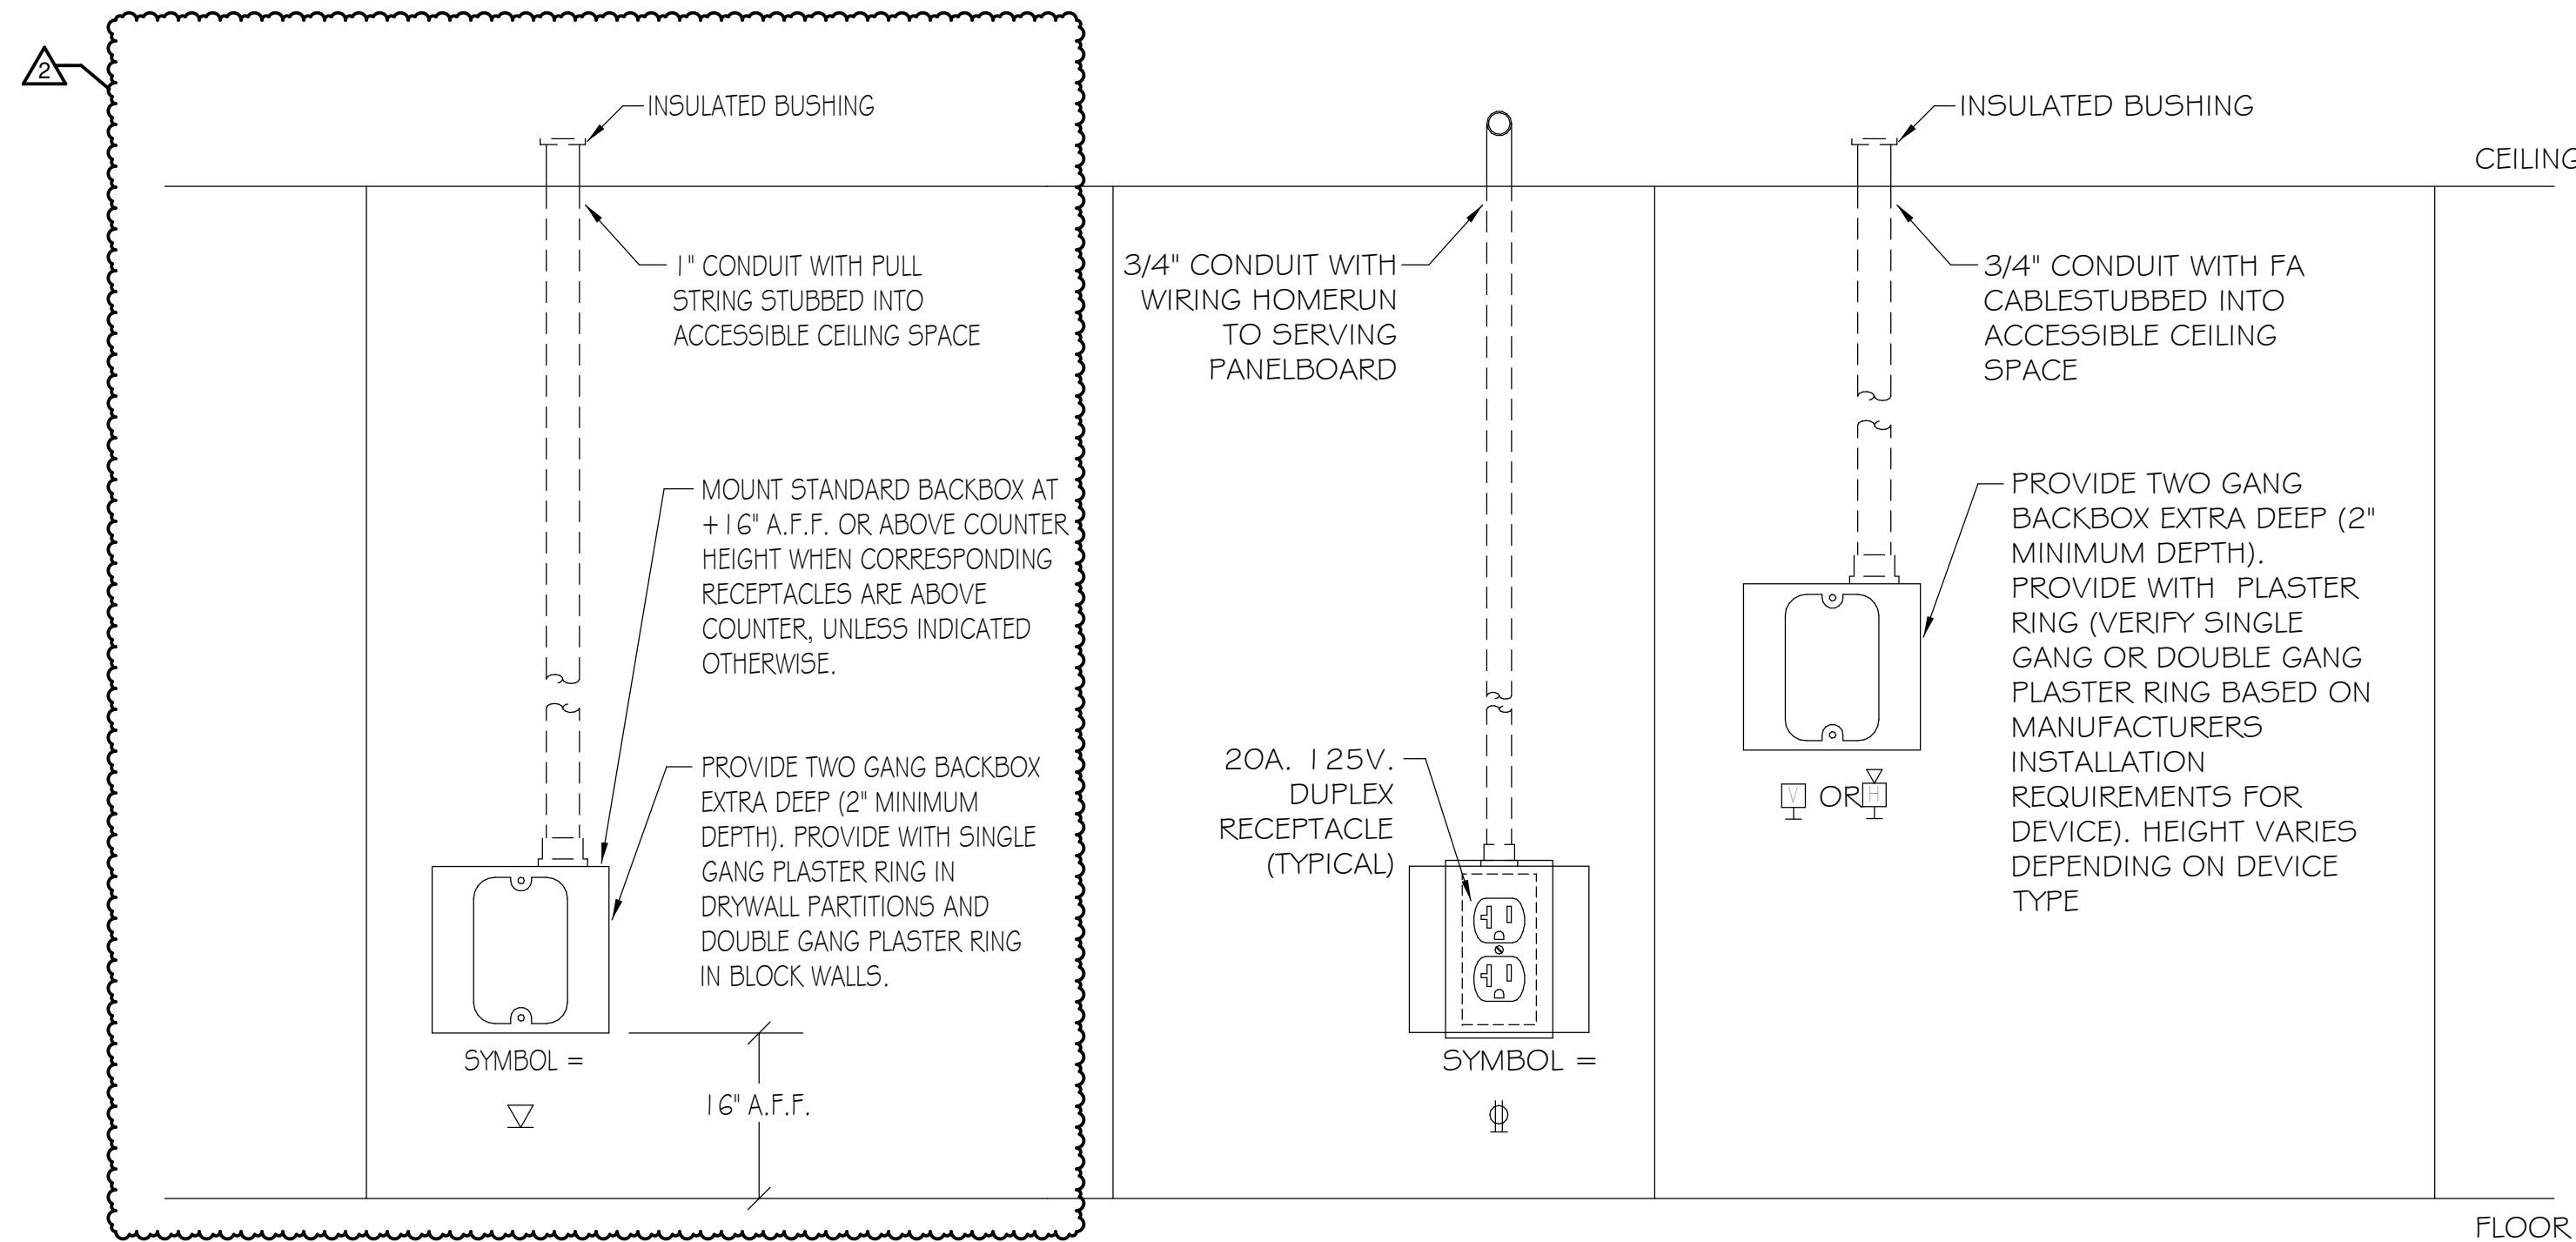

JUNCTION BOX ROUGH-IN DETAIL
NO SCALE

- NOTES:
1. DETAILS ARE FOR REFERENCE ONLY.
 2. NOT ALL DEVICES ARE REQUIRED FOR THIS PROJECT.
 3. PROVIDE TWO GANG BACKBOXES (2" MINIMUM DEPTH) WITH ALL RECEPTACLE OUTLETS.
 4. PROVIDE COVER PLATES FOR ALL NEW DEVICES, MATCH EXISTING BUILDING STANDARD COLOR (IVORY, V.I.F.)

INTERIOR LUMINAIRE SCHEDULE							
TYPE	DESCRIPTION	MOUNTING	LIGHT SOURCE	VOLTAGE	INPUT WATTS	MANUFACTURER & CATALOG NUMBER	ALTERNATE MANUFACTURER
L1	4" TUBE, 6" ARM	WALL	LED	277 V	28	ALCON 11703-4-HI-BA-40K-6-2-010	REQUIRES APPROVAL OF ARCHITECT PRIOR TO BID
L2	8" TUBE, 18" ARM	WALL	LED	277 V	56	ALCON 11703-8-HI-BA-40K-18-2-010	REQUIRES APPROVAL OF ARCHITECT PRIOR TO BID
L3	DECORATIVE GEOMETRIC PENDANT	SUSPENDED	LED	277 V	9.8	EUREKA: MARRO 4228-27	REQUIRES APPROVAL OF ARCHITECT PRIOR TO BID
L4	DECORATIVE GEOMETRIC PENDANT	SUSPENDED	LED	277 V	9.8	EUREKA: MARRO 4228-20	REQUIRES APPROVAL OF ARCHITECT PRIOR TO BID
L5	DECORATIVE GEOMETRIC PENDANT	SUSPENDED	LED	277 V	9.8	EUREKA: MARRO 4228-13	REQUIRES APPROVAL OF ARCHITECT PRIOR TO BID
L6	DECORATIVE SCONCE	WALL	LED	277 V	60	WEST ELM: HENRY SCONCE	REQUIRES APPROVAL OF ARCHITECT PRIOR TO BID
L7	4" DOWNLIGHT, MEDIUM WIDE DISTRIBUTION, CLEAR TRIM, SEMI SPECULAR FINISH	RECESSED	LED	277 V	34.4	GOTHAM: IVO IVO45Q-D-35LM-40K-80CRI-MWD-MINI O -MVOLT-ZT-NCH-SF-P-AR-L55-F	REQUIRES APPROVAL OF ARCHITECT PRIOR TO BID
L7A	4" DOWNLIGHT, MEDIUM WIDE DISTRIBUTION, CLEAR TRIM, SEMI SPECULAR FINISH	RECESSED	LED	277 V	15	GOTHAM: IVO IVO45Q-D-15LM-40K-80CRI-MWD-MINI O -MVOLT-ZT-NCH-SF-P-AR-L55-F	REQUIRES APPROVAL OF ARCHITECT PRIOR TO BID
L7e	4" DOWNLIGHT, MEDIUM WIDE DISTRIBUTION, CLEAR TRIM, SEMI SPECULAR FINISH, EMERGENCY BATTERY PACK AND INTEGRATED TEST SWITCH	RECESSED	LED	277 V	34.4	GOTHAM: IVO IVO45Q-D-35LM-40K-80CRI-MWD-MINI O -MVOLT-ZT-NCH-SF-P-AR-L55-F, E7W	REQUIRES APPROVAL OF ARCHITECT PRIOR TO BID
L7W	4" DOWNLIGHT, WALLWASH, CLEAR TRIM, SEMI SPECULAR FINISH	RECESSED	LED	277 V	26.8	GOTHAM: IVO IVO45Q-WW-25LM-40K-90CRI-MINI O-MV OLT-ZT-NCH-SF-LW-AR-L55-F	REQUIRES APPROVAL OF ARCHITECT PRIOR TO BID

- NOTES:
1. REFER TO ARCHITECTURAL ELEVATIONS FOR EXACT MOUNTING HEIGHTS.
 2. ORIENT THE DOWNLIGHT SUCH THAT THE EMERGENCY BATTERY IS CLOSEST TO THE CEILING ACCESS PANEL.

- GENERAL NOTES:
- a. CONTRACTOR TO PROVIDE NECESSARY MOUNTING HARDWARE AND LABOR FOR LUMINAIRES.
 - b. PROVIDE OPTIONS AND ACCESSORIES AS REQUIRED TO INSTALL LUMINAIRES IN MOUNTING SURFACES AS SHOWN ON THE PLANS.
 - c. PROVIDE ALL WIRING, CABLING, AND ACCESSORIES REQUIRED FOR PROPER FUNCTIONALITY OF LUMINAIRES UTILIZING OCCUPANCY SENSORS, DAYLIGHT HARVESTING, AND/OR DIMMING.
 - d. INTEGRATE LUMINAIRES INTO EXISTING LIGHTING CONTROLS AND CONNECT TO EXISTING RELAY PANEL; VERIFY REQUIREMENTS IN FIELD.
 - e. SUBSTITUTE LUMINAIRES FROM MANUFACTURERS OTHER THAN THOSE LISTED SHALL BE SUBMITTED FOR PRE-APPROVAL (10) DAYS PRIOR TO SUBMISSION OF BID.
 - f. COLORS AND FINISHES TO BE SELECTED BY THE ARCHITECT.

BIDDING NOTE
SEE DRAWINGS ME1.00 FOR GENERAL NOTES AND ADDITIONAL DETAILS APPLICABLE TO THIS TRADE'S WORK.

MOUNTING HEIGHT NOTE
REFER TO ARCHITECTURAL PLANS FOR ADDITIONAL INFORMATION REGARDING MOUNTING HEIGHTS AND LOCATIONS OF ELECTRICAL DEVICES BEFORE ROUGH-IN.

WHERE CONFLICTS BETWEEN ELECTRICAL & ARCHITECTURAL ELEVATIONS ARISE, CONTRACTOR TO VERIFY WITH ARCHITECT/ENGINEER TEAM PRIOR TO ROUGH-IN.

NOTE
INCIDENTAL WORK MAY ALSO BE NECESSARY DUE TO CHANGES AFFECTING, SITE WORK, ELECTRICAL, OR OTHER SYSTEMS. SUCH INCIDENTAL WORK IS ALSO PART OF THIS CONTRACT. INSPECT THOSE AREAS, COORDINATE WITH OTHER TRADES, AND ASCERTAIN WORK NEEDED, AND DO THAT WORK IN ACCORD WITH THE CONTRACT REQUIREMENTS, AT NO ADDITIONAL COST. THE REMOVAL & REINSTALLATION OF EXISTING WORK TO ACCOMMODATE CHANGES TO EXISTING, OR INSTALLATION OF, ELECTRICAL, OTHER SYSTEMS IS ALSO PART OF THIS CONTRACT.

NOTE
CONTRACTOR SHALL BE RESPONSIBLE FOR THE SUPPORT OF LIGHT FIXTURES WHERE ACCESSIBLE CEILINGS ARE BEING REMOVED AND REPLACED. ALL EXISTING LIGHT FIXTURES ARE NOT SUPPORTED INDEPENDENTLY OF THE CEILING GRID. CONTRACTOR IS RESPONSIBLE FOR SUPPORTING EXISTING LIGHT FIXTURES IN PLACE WHERE MARKED "XRT". AT CONCLUSION OF PROJECT ALL EXISTING AND NEW LIGHT FIXTURES IN AREAS OF CEILING REPLACEMENT SHALL BE SUPPORTED INDEPENDENTLY OF THE CEILING GRID WITH SUPPORT WIRES CONNECTED TO STRUCTURAL ELEMENTS OF THE BUILDING AT OPPOSITE CORNERS.

NOTE
EXISTING CONDITIONS WERE OBTAINED FROM EXISTING AS-BUILT DRAWINGS AND CURSORY FIELD OBSERVATION. THIS CONTRACTOR SHALL IDENTIFY ANY DISCREPANCIES IN THE FIELD AND REPORT THEM TO THE ENGINEER.

NO	ISSUE	DATE
1	Bid Set	06/16/2025
2	Addendum 1	06/30/2025
	Addendum 2	07/03/2025

**ELECTRICAL
NOTES,
DETAILS, AND
SCHEDULES**