

ADDENDUM NO. 1

DATE: June 30, 2025

Project: Glenview Public Library
Café Renovation

Architect: Studio GC architecture + interiors
223 W. Jackson Blvd. Suite 1200
Chicago, Illinois 60606

Project No.: 25007

1.1 SUMMARY

- A. The Bidding Documents and Project Manual dated June 16, 2025 and Drawings dated June 16, 2025 for the above referenced project are hereby modified and revised as follows.
- B. The information contained within this Addendum modifies, supplements or replaces information contained in the Project Manual and the Contract Drawings and is hereby made a part of the Contract Documents.
- C. Acknowledge receipt of this Addendum on the Bid Form. FAILURE TO DO SO MAY SUBJECT THE BIDDER TO DISQUALIFICATION.
- D. The Bidding Documents include the Project Manual dated June 16, 2025, the Drawings dated June 16, 2025, and Addenda issued prior to the receipt of bids.

1.2 PROJECT MANUAL

- A. None

1.3 DRAWINGS

- A. Sheet AD1.00 – Main Level Demolition Plan and RCP – Café / Lobby
 - 1. Replace this sheet in its entirety.
- B. Sheet AD1.10 – Main Level Demolition Plan – Youth
 - 1. Replace this sheet in its entirety.
- C. Sheet AD2.00 – Main Level Demolition RCP - Youth
 - 1. Replace this sheet in its entirety.
- D. Sheet A1.00 – Main Level New Floorplan and RCP – Café / Lobby
 - 1. Replace this sheet in its entirety.
- E. Sheet A1.10 – Main Level New Floorplan – Youth

1. Replace this sheet in its entirety.
 - F. Sheet A2.00 – Main Level New RCP – Youth
 1. Replace this sheet in its entirety.
 - G. Sheet A3.00 – Finishes, interior elevations & details
 1. Replace this sheet in its entirety.
 - H. Sheet A4.00 – Furniture Plan – For Reference Only
 1. Replace this sheet in its entirety.
 - I. Sheet E1.00 – Demolition and New Work Electrical and Lighting Plans
 1. Replace this sheet in its entirety.
 - J. Sheet E1.01 – Demolition and New Work Electrical and Lighting Plans
 1. Replace this sheet in its entirety.
 - K. Sheet E2.01 – Electrical Notes, Details, and Schedules
 1. Replace this sheet in its entirety.
 - L. Sheet FP1.00 – First Floor – Fire Protection Plan, Specs., Details – Café
 1. Replace this sheet in its entirety.
- 1.4 CLARIFICATIONS
- A. During the pre-construction meeting, onsite dumpster and porta-potty locations will be coordinated with the owner within their parking and service drive area.

End Addendum 009113.1

This Addendum consists of 2 pages.

Attachments:

- Project Manual: None
- Drawings: AD1.00, AD1.10, AD2.00, A1.00, A1.10, A2.00, A3.00, A4.00, E1.00, E1.01, E2.01, FP1.00
- Pre-Bid Sign In

Client: Glenview Public Library

Project: Café Renovation

Project No.: 25007


Date: Wednesday, June 25, 2025 @ 10:00 a.m.

Meeting: Prebid Meeting at Library

SIGN-IN SHEET







PLEASE PRINT LEGIBLY

NAME	COMPANY NAME	GC/SUB	PHONE	CELL PHONE	E-MAIL ADDRESS
Cameron Cheave	Lo Destro Const	GC	630 441 5980		ccheave@lodestroconstruction.com
Mark R. Landig	Construction Solutions	GC	708 239-6001	630 974-0128	bids@csofi.com
Cassidy Tarpey	BEAR	GC	847-621-9003		m.k12@bearcc.com
Pat Noonan	MACRC	GC	630 327 3836		pnoonan@captrunion.org
DAVID DAMPTZ	STRUXC	GC	312-925-0522		DD@STRUXC.COM
JOSE MOLINA	TOUCHSTONE GROUP	GC	773-418-2572		JMOLINA@TSGRE.COM
John Norris	Temporary Wall Systems	Sub	312-300-3436		john.norris@tempwallsystems.com
Sebastian Bransky	Stuckey Construction	GC	847-336-8575		Sebastian@stuckeyconstruction.com
David Merza	Superb Steel Construction	GC	773-410-2292		DavidM@SuperbSteel.com
Ken Colerich	TROOP Contracting	GC	630 568 5252		estimating@troopcontracting.com
Matt Boller	Boller Construction	GC	847-662-5560		Estimating@bollerconstruction.com
Amanda Valentino	Construction Inc.	GC	672 491-4738		matt@buildwithci.com
Damian Poleszuk	LZ Design Build	GC	773 443 1835		dpoleszuk@LZdesignbuild.com
George Fandh	Fandh Const. Inc	GC	847 779 3616		Info@fandhconstructioninc.com
Robert Marin	BLLS	GC	815-274-3262		brandi@bec-lean-services.com
AUSTIN LYONS	COOLVU	SUB	224-472-3456		AUSTIN.LYONS@COOLVU.COM

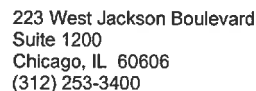


Meeting: Prebid Meeting at Library

Ricardo Pinel	ECO Construction	Sub TTB 787 7238	ricardo-pinel@yahoo.com
Constantin Boudas	Midwest Services	TTB-810-5204	midwestservices2010@gmail.com

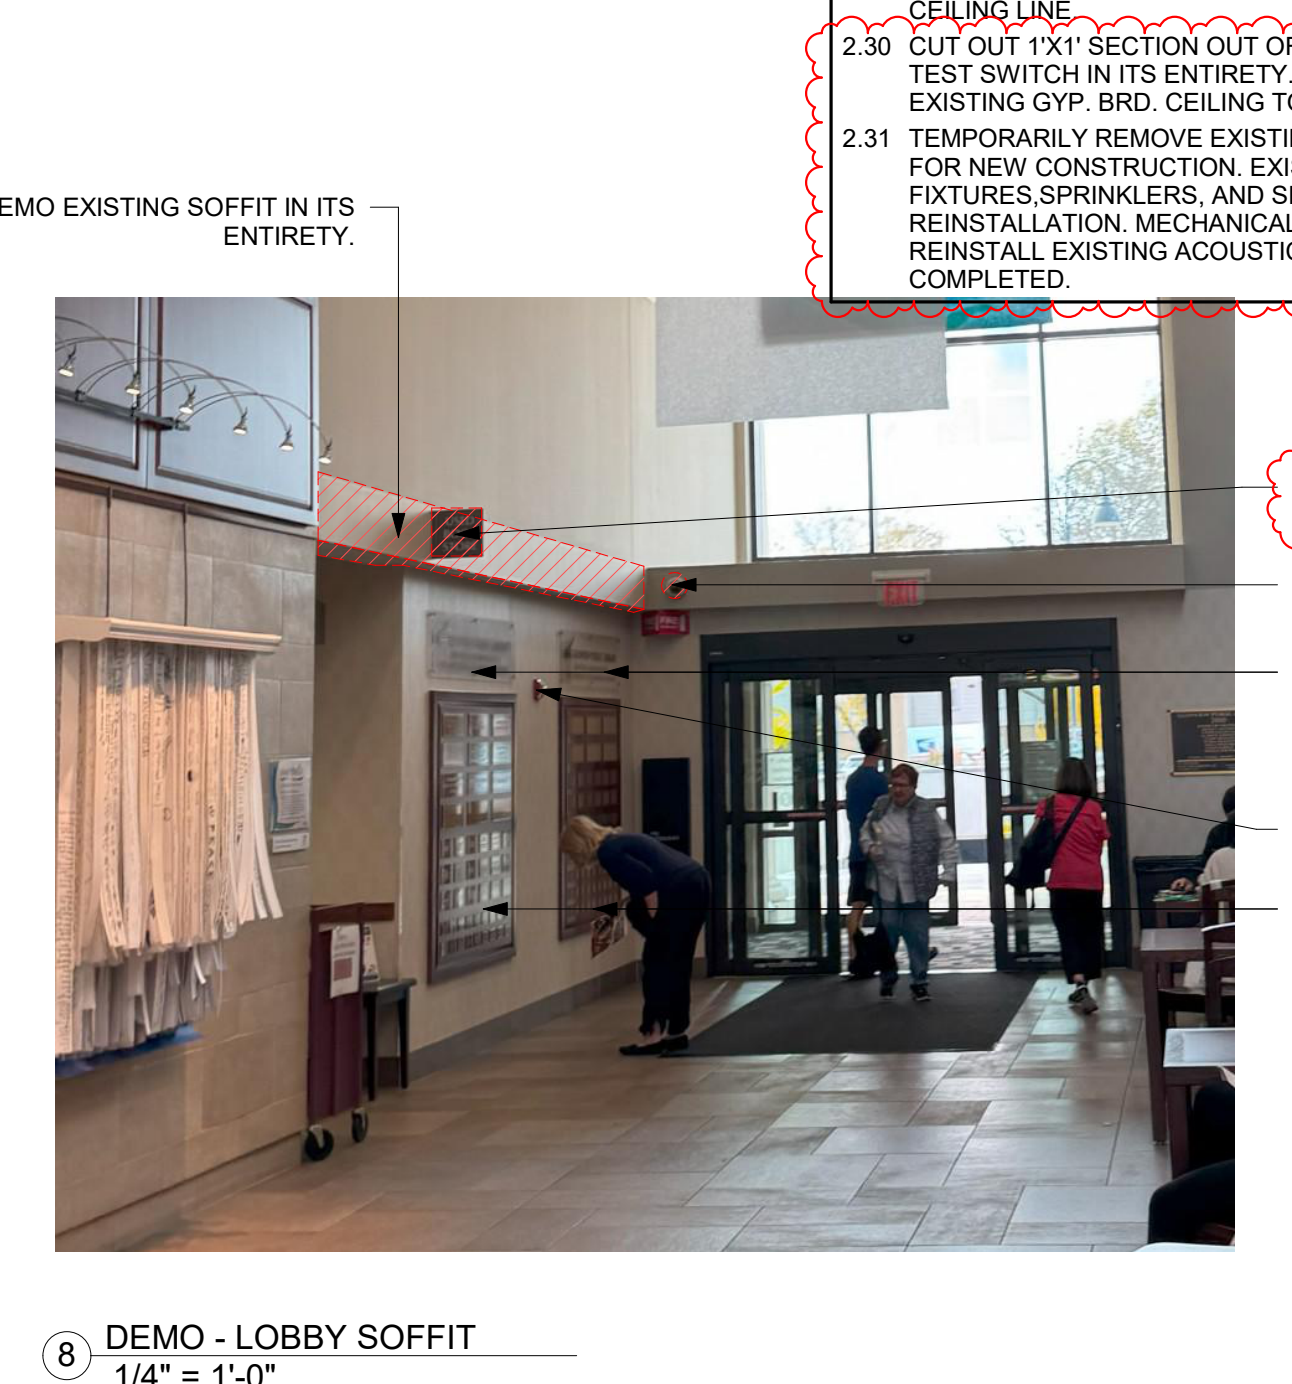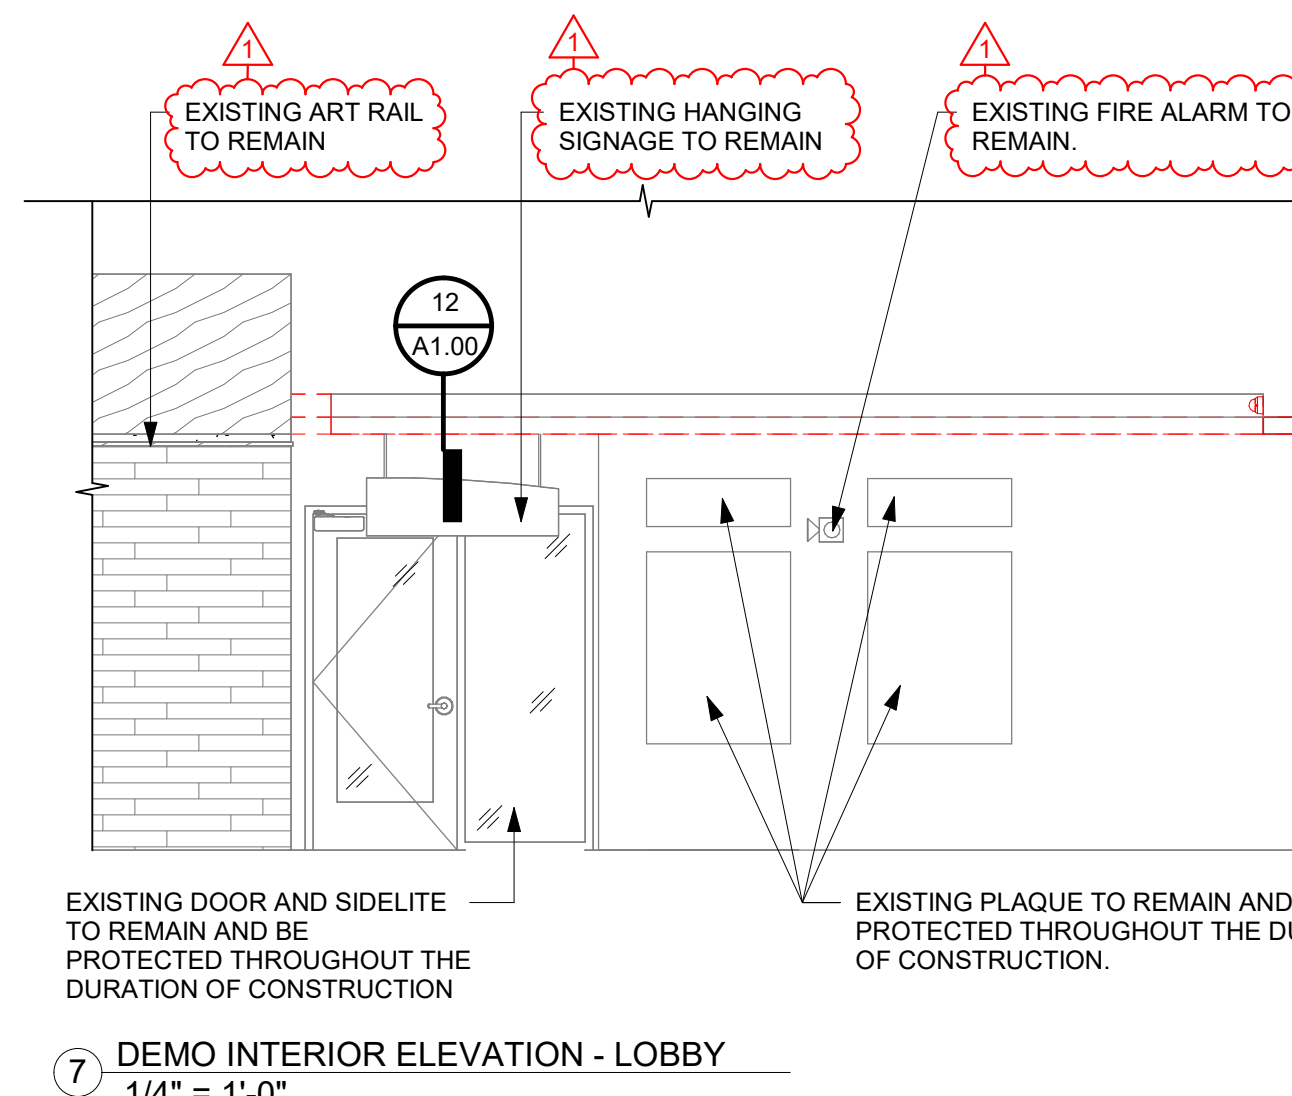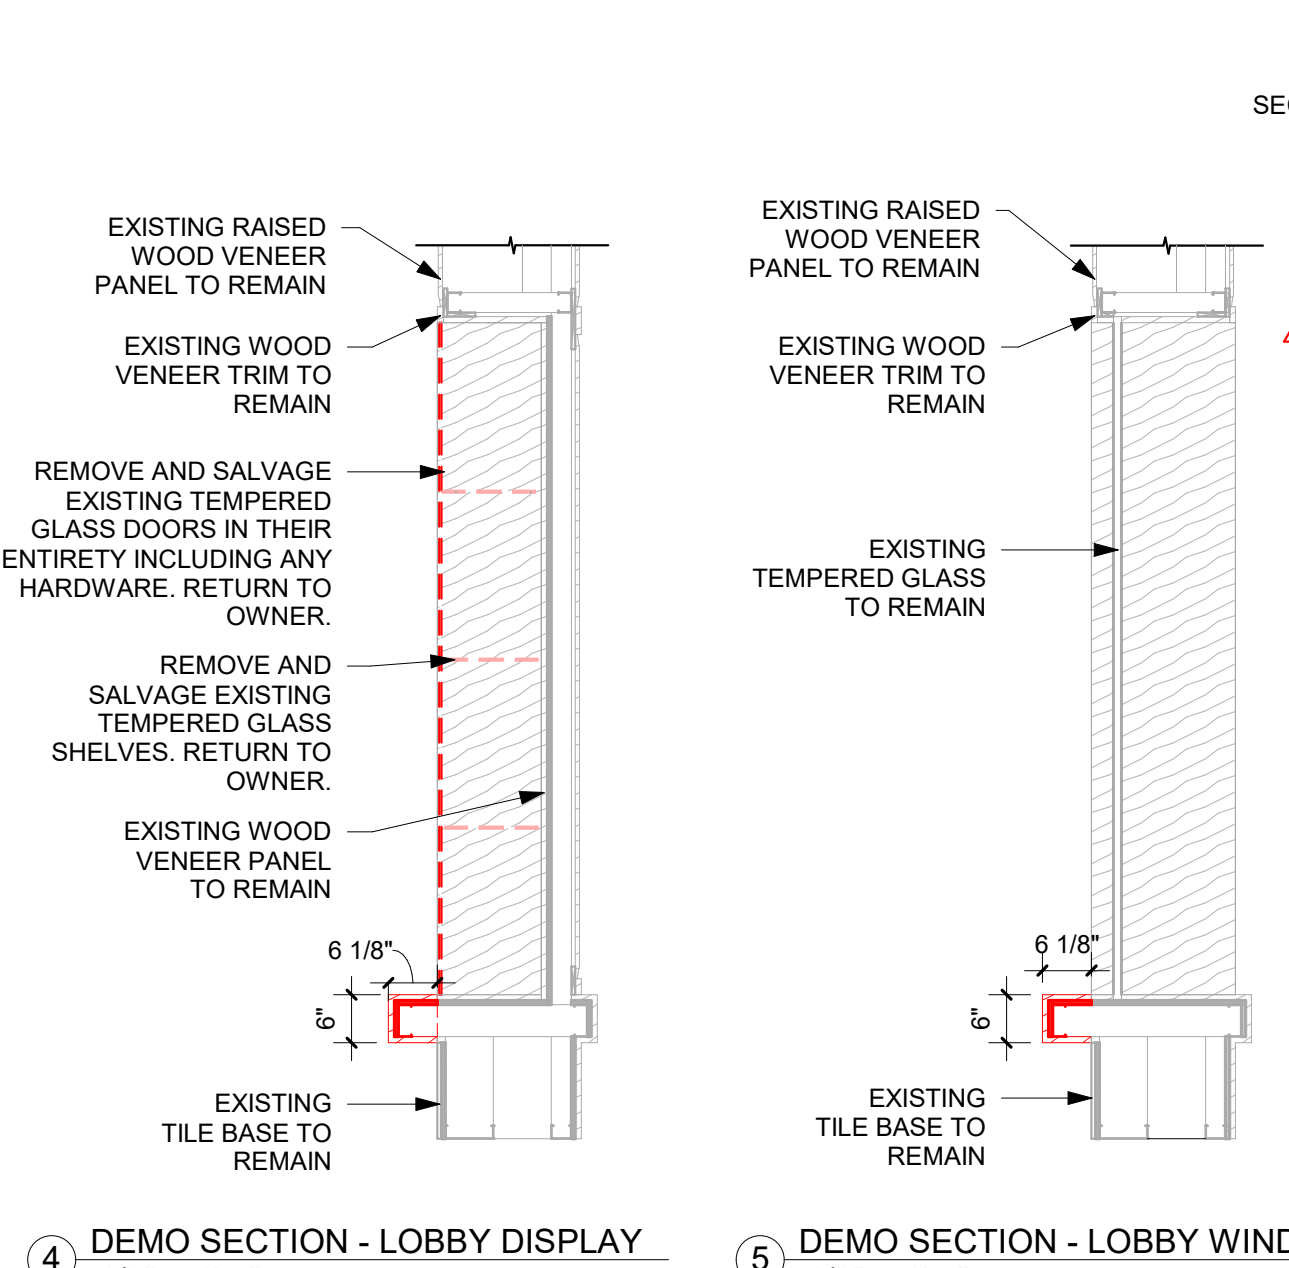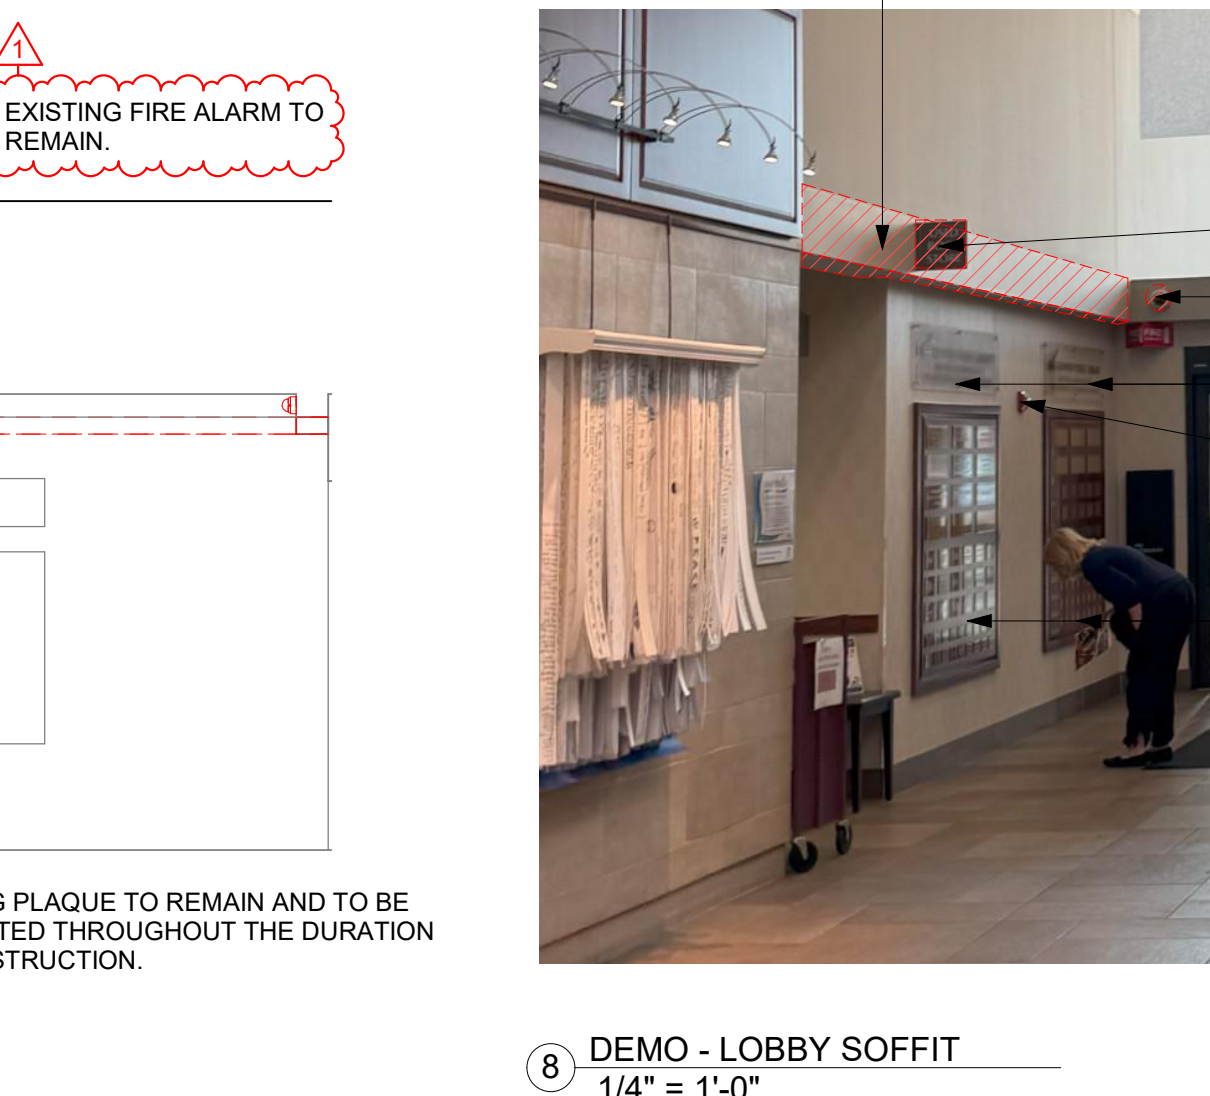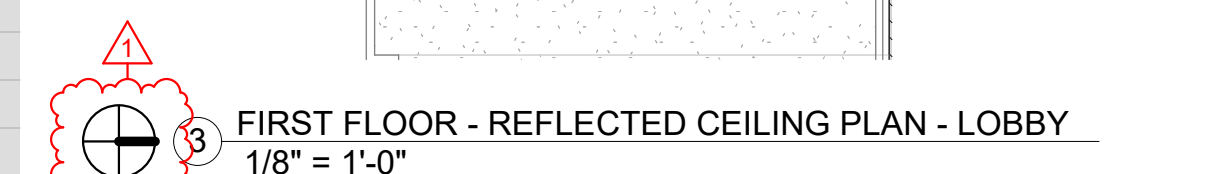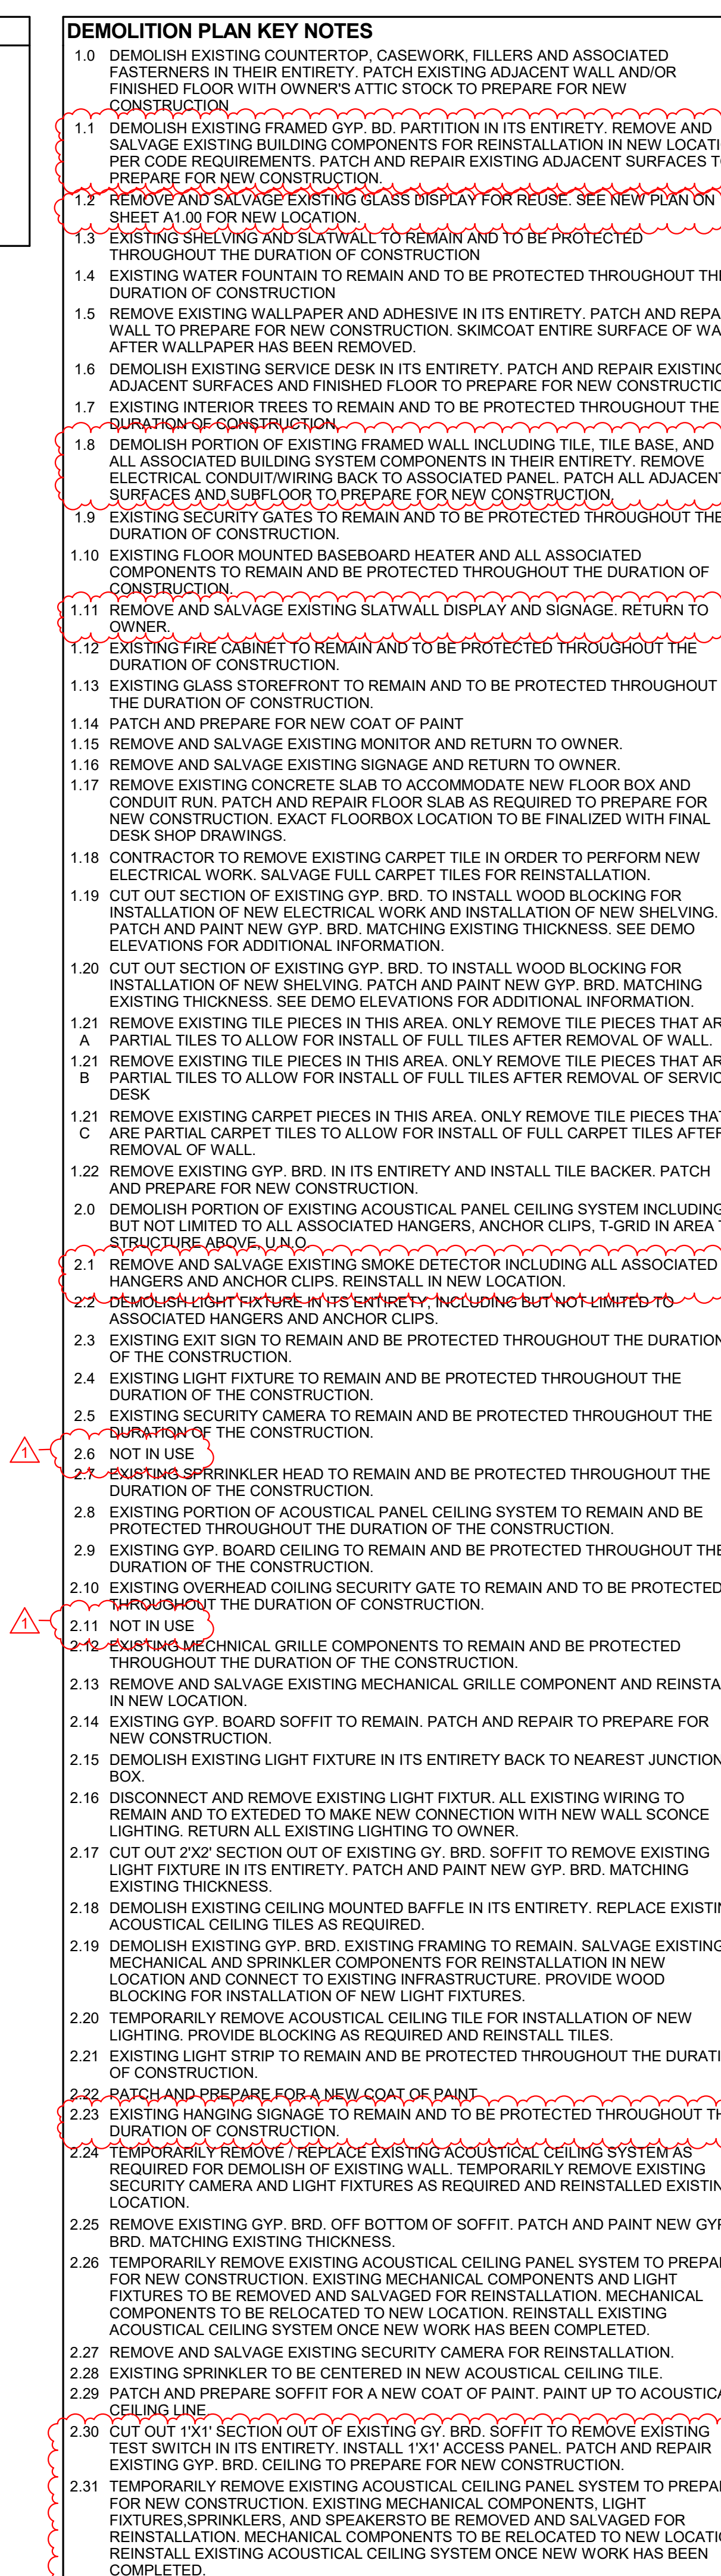
[illegible]

**MAIN LEVEL
DEMOLITION
PLAN AND RCP
CAFE / LOBBY**

AD1 00

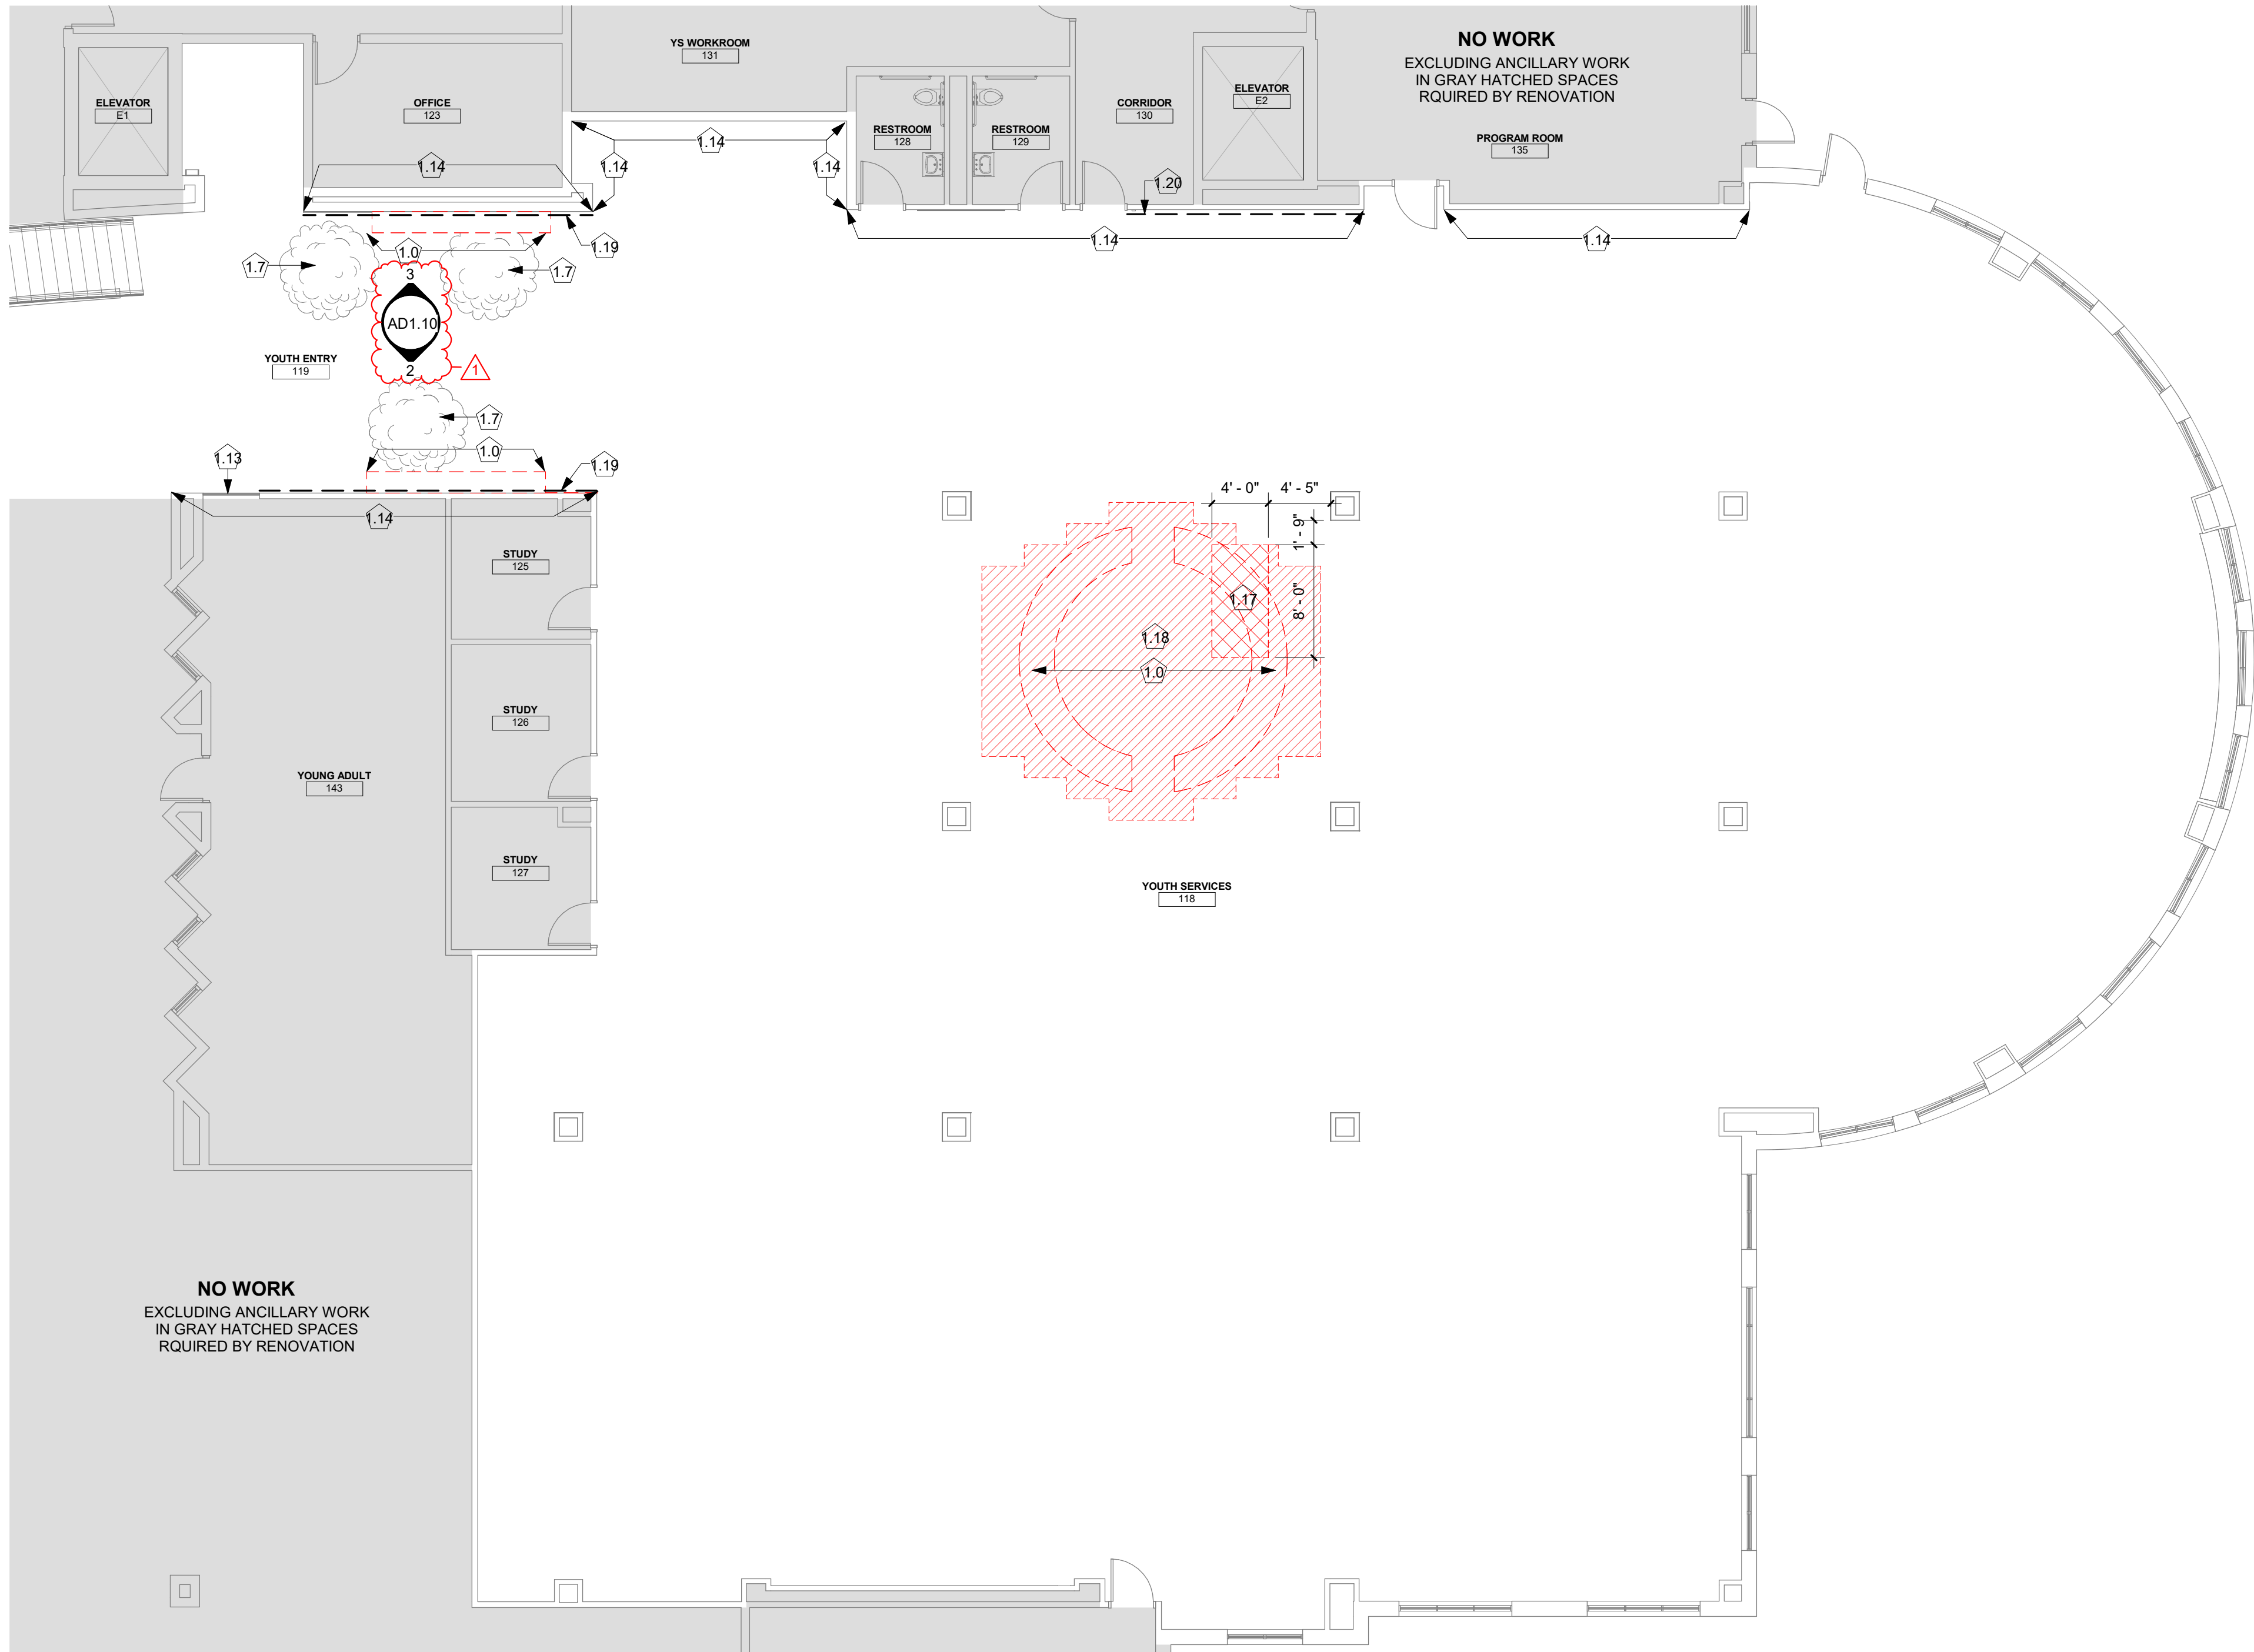

1 FIRST FLOOR - DEMO FLOOR PLAN - YOUTH
1/8" = 1'-0"

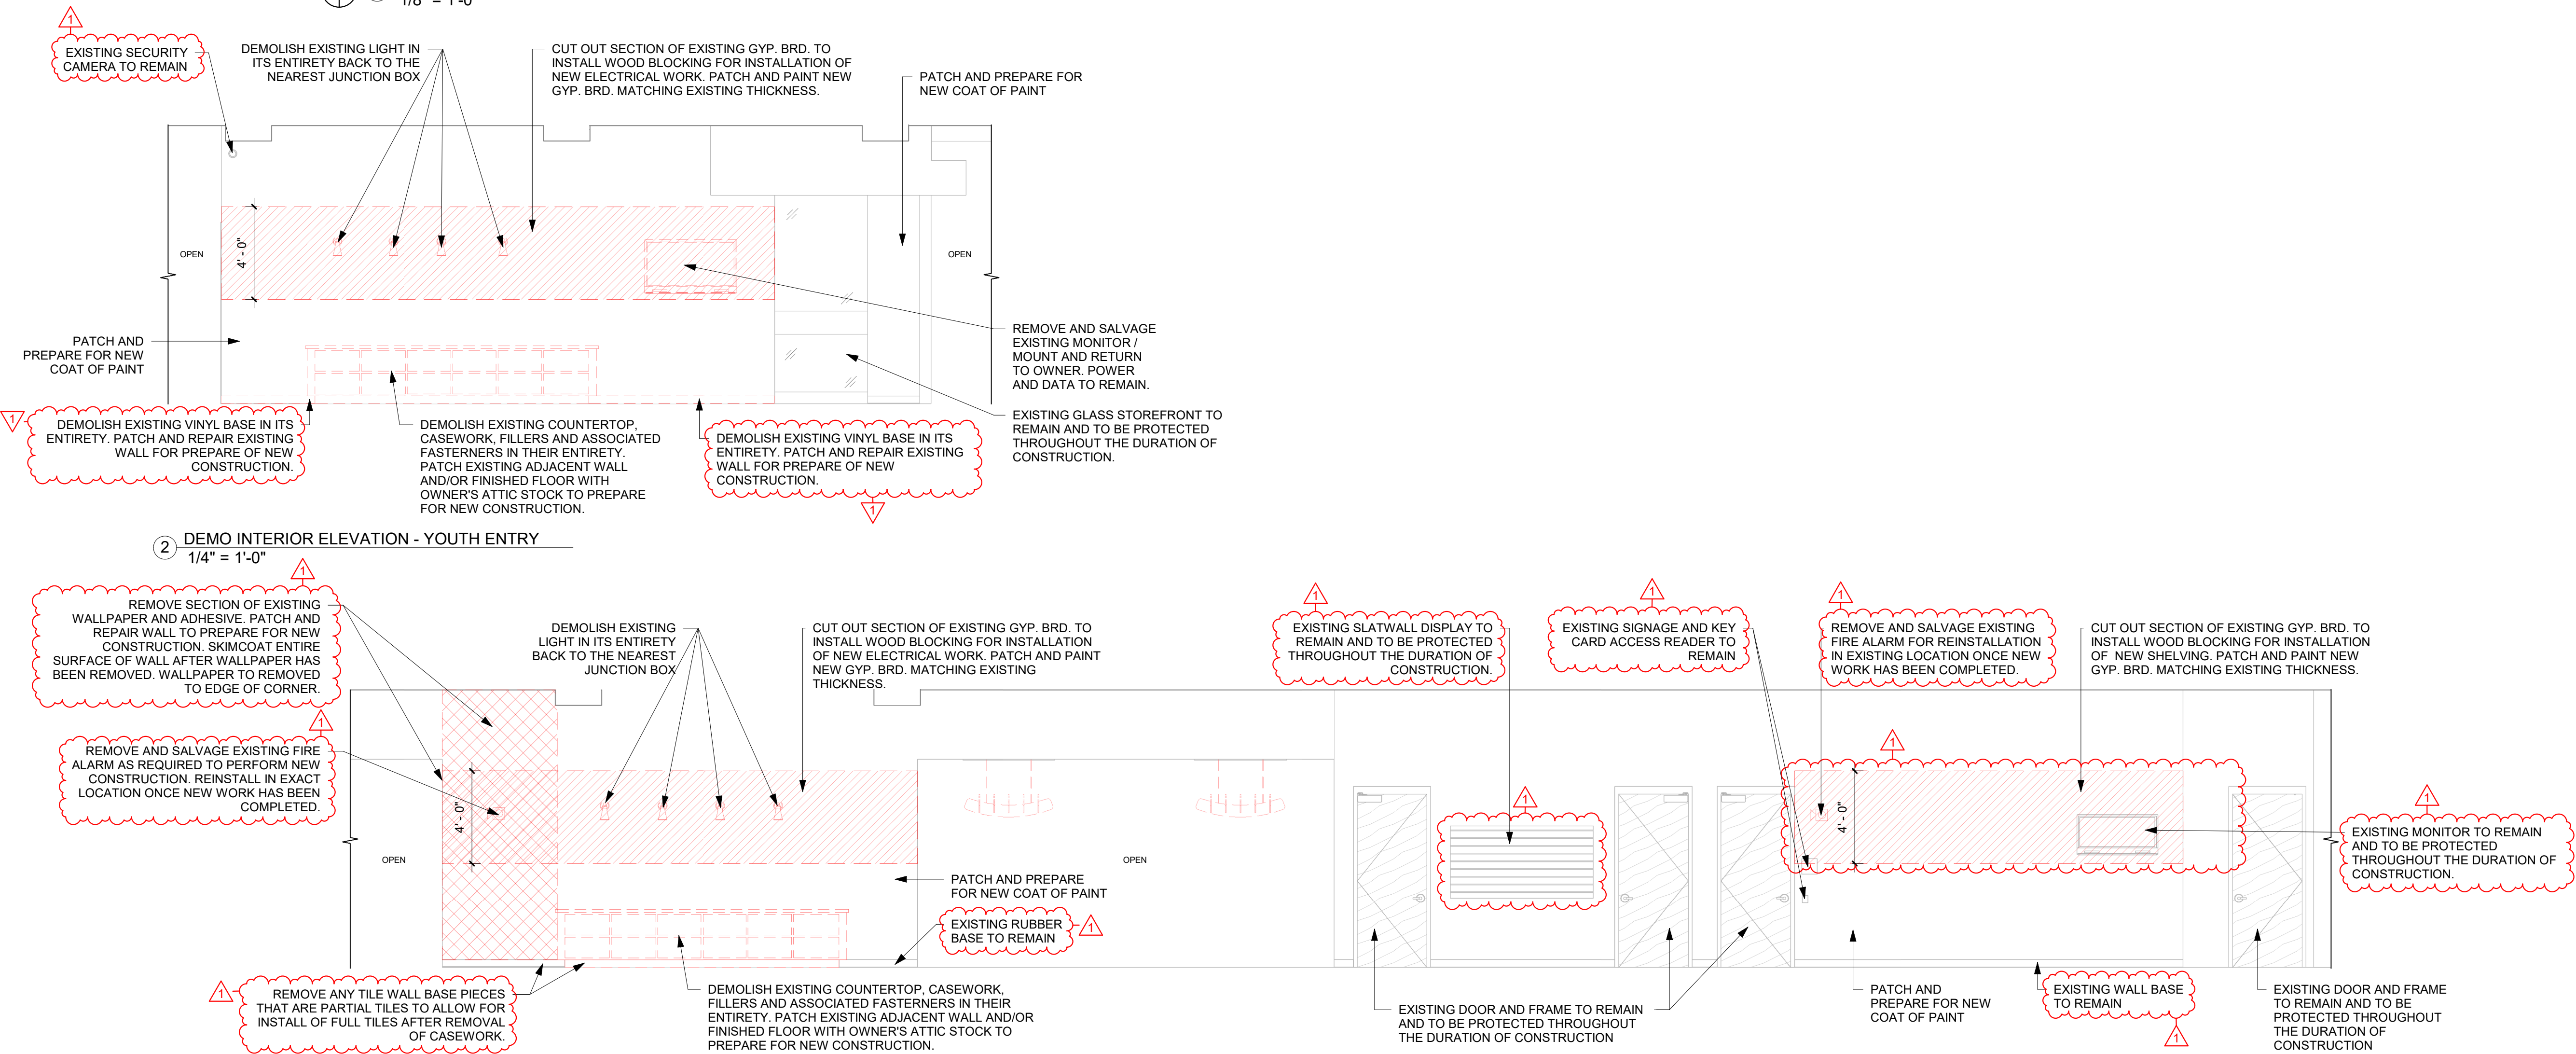

2 DEMO INTERIOR ELEVATION - YOUTH ENTRY
1/4" = 1'-0"


3 DEMO INTERIOR ELEVATION - YOUTH ENTRY
1/4" = 1'-0"

DEMOLITION LEGEND		
	WALL PARTITION TO BE REMOVED.	
	ITEM TO BE REMOVED	
	PORTION OF AREA TO BE REMOVED. COORDINATE EXACT EXTENDS WITH NEW WORK PLANS	


DEMOLITION PLAN KEY NOTES		
1.0	DEMOLISH EXISTING COUNTERTOP, CASEWORK, FILLERS AND ASSOCIATED FASTENERS IN THEIR ENTIRETY. PATCH EXISTING ADJACENT WALL AND/OR FINISHED FLOOR WITH OWNER'S ATTIC STOCK TO PREPARE FOR NEW CONSTRUCTION.	
1.1	DEMOLISH EXISTING FRAMED GYP. BD. PARTITION IN ITS ENTIRETY. REMOVE AND SALVAGE EXISTING BUILDING COMPONENTS FOR REINSTALLATION IN NEW LOCATION PER CODE REQUIREMENTS. PATCH AND REPAIR EXISTING ADJACENT SURFACES TO PREPARE FOR NEW CONSTRUCTION.	
1.2	REMOVE AND SALVAGE EXISTING GLASS DISPLAY FOR REUSE. SEE NEW PLAN ON SHEET A1.00 FOR NEW LOCATION.	
1.3	EXISTING SHELVING AND SLATWALL TO REMAIN AND TO BE PROTECTED THROUGHOUT THE DURATION OF CONSTRUCTION.	
1.4	EXISTING WATER FOUNTAIN TO REMAIN AND TO BE PROTECTED THROUGHOUT THE DURATION OF CONSTRUCTION.	
1.5	REMOVE EXISTING WALLPAPER AND ADHESIVE IN ITS ENTIRETY. PATCH AND REPAIR WALL TO PREPARE FOR NEW CONSTRUCTION. SKIMCOAT ENTIRE SURFACE OF WALL AFTER WALLPAPER HAS BEEN REMOVED.	
1.6	DEMOLISH EXISTING SERVICE DESK IN ITS ENTIRETY. PATCH AND REPAIR EXISTING ADJACENT SURFACES AND FINISHED FLOOR TO PREPARE FOR NEW CONSTRUCTION.	
1.7	EXISTING INTERIOR TREES TO REMAIN AND TO BE PROTECTED THROUGHOUT THE DURATION OF CONSTRUCTION.	
1.8	DEMOLISH PORTION OF EXISTING FRAMED WALL INCLUDING TILE, TILE BASE, AND ALL ASSOCIATED BUILDING SYSTEM COMPONENTS IN THEIR ENTIRETY. REMOVE ELECTRICAL CONDUIT WIRING BACK TO ASSOCIATED PANEL. PATCH ALL ADJACENT SURFACES AND SURFLOOR TO PREPARE FOR NEW CONSTRUCTION.	
1.9	EXISTING SECURITY GATES TO REMAIN AND TO BE PROTECTED THROUGHOUT THE DURATION OF CONSTRUCTION.	
1.10	EXISTING FLOOR MOUNTED BASEBOARD HEATER AND ALL ASSOCIATED COMPONENTS TO REMAIN AND BE PROTECTED THROUGHOUT THE DURATION OF CONSTRUCTION.	
1.11	REMOVE AND SALVAGE EXISTING SLATWALL DISPLAY AND SIGNAGE. RETURN TO OWNER.	
1.12	EXISTING FIRE CABINET TO REMAIN AND TO BE PROTECTED THROUGHOUT THE DURATION OF CONSTRUCTION.	
1.13	EXISTING GLASS STOREFRONT TO REMAIN AND TO BE PROTECTED THROUGHOUT THE DURATION OF CONSTRUCTION.	
1.14	PATCH AND PREPARE FOR NEW COAT OF PAINT.	
1.15	REMOVE AND SALVAGE EXISTING MONITOR AND RETURN TO OWNER.	
1.16	REMOVE AND SALVAGE EXISTING SIGNAGE AND RETURN TO OWNER.	
1.17	REMOVE EXISTING CONCRETE SLAB TO ACCOMMODATE NEW FLOOR BOX AND CONDUIT RUN. PATCH AND REPAIR FLOOR SLAB AS REQUIRED TO PREPARE FOR NEW CONSTRUCTION. EXACT FLOORBOX LOCATION TO BE FINALIZED WITH FINAL DESK SHOP DRAWINGS.	
1.18	CONTRACTOR TO REMOVE EXISTING CARPET TILE IN ORDER TO PERFORM NEW ELECTRICAL WORK. SALVAGE FULL CARPET TILES FOR REINSTALLATION.	
1.19	CUT OUT SECTION OF EXISTING GYP. BRD. TO INSTALL WOOD BLOCKING FOR INSTALLATION OF NEW ELECTRICAL WORK AND INSTALLATION OF NEW SHELVING. PATCH AND PAINT NEW GYP. BRD. MATCHING EXISTING THICKNESS. SEE DEMO ELEVATIONS FOR ADDITIONAL INFORMATION.	
1.20	CUT OUT SECTION OF EXISTING GYP. BRD. TO INSTALL WOOD BLOCKING FOR INSTALLATION OF NEW SHELVING. PATCH AND PAINT NEW GYP. BRD. MATCHING EXISTING THICKNESS. SEE DEMO ELEVATIONS FOR ADDITIONAL INFORMATION.	
1.21	REMOVE EXISTING TILE PIECES IN THIS AREA. ONLY REMOVE TILE PIECES THAT ARE A PARTIAL TILES TO ALLOW FOR INSTALL OF FULL TILES AFTER REMOVAL OF WALL.	
1.22	REMOVE EXISTING CARPET PIECES IN THIS AREA. ONLY REMOVE TILE PIECES THAT ARE C ARE PARTIAL CARPET TILES TO ALLOW FOR INSTALL OF FULL CARPET TILES AFTER REMOVAL OF WALL.	
1.23	REMOVE EXISTING GYP. BRD. IN ITS ENTIRETY AND INSTALL TILE BACKER. PATCH AND PREPARE FOR NEW CONSTRUCTION.	
2.0	DEMOLISH PORTION OF EXISTING ACOUSTICAL PANEL CEILING SYSTEM INCLUDING BUT NOT LIMITED TO ALL ASSOCIATED HANGERS, ANCHOR CLIPS, T-GRID IN AREA TO STRUCTURE ABOVE. PATCH AND PREPARE FOR NEW CONSTRUCTION.	
2.1	REMOVE AND SALVAGE EXISTING SMOKE DETECTOR INCLUDING ALL ASSOCIATED HANGERS AND ANCHOR CLIPS. REINSTALL IN NEW LOCATION.	
2.2	DEMOLISH LIGHT FIXTURE IN ITS ENTIRETY. INCLUDING BUT NOT LIMITED TO ASSOCIATED HANGERS AND ANCHOR CLIPS.	
2.3	EXISTING EXIT SIGN TO REMAIN AND BE PROTECTED THROUGHOUT THE DURATION OF THE CONSTRUCTION.	
2.4	EXISTING LIGHT FIXTURE TO REMAIN AND BE PROTECTED THROUGHOUT THE DURATION OF THE CONSTRUCTION.	
2.5	EXISTING SECURITY CAMERA TO REMAIN AND BE PROTECTED THROUGHOUT THE DURATION OF THE CONSTRUCTION.	
2.6	NOT IN USE.	
2.7	EXISTING SPRINKLER HEAD TO REMAIN AND BE PROTECTED THROUGHOUT THE DURATION OF THE CONSTRUCTION.	
2.8	EXISTING PORTION OF ACOUSTICAL PANEL CEILING SYSTEM TO REMAIN AND BE PROTECTED THROUGHOUT THE DURATION OF THE CONSTRUCTION.	
2.9	EXISTING GYP. BOARD SOFFIT TO REMAIN. PATCH AND REPAIR TO PREPARE FOR NEW CONSTRUCTION.	
2.10	DEMOLISH EXISTING LIGHT FIXTURE IN ITS ENTIRETY BACK TO NEAREST JUNCTION BOX.	
2.11	DISCONNECT AND REMOVE EXISTING LIGHT FIXTURE. ALL EXISTING WIRING TO REMAIN AND TO BE EXTENDED TO MAKE NEW CONNECTION WITH NEW WALL SCONCE LIGHTING. RETURN ALL EXISTING LIGHTING TO OWNER.	
2.12	CUT OUT 2X2 SECTION OUT OF EXISTING GY. BRD. SOFFIT TO REMOVE EXISTING LIGHT FIXTURE IN ITS ENTIRETY. PATCH AND PAINT NEW GYP. BRD. MATCHING EXISTING THICKNESS.	
2.13	DEMOLISH EXISTING CEILING MOUNTED BAFFLE IN ITS ENTIRETY. REPLACE EXISTING ACOUSTICAL CEILING TILES AS REQUIRED.	
2.14	DEMOLISH EXISTING GYP. BRD. EXISTING FRAMING TO REMAIN. SALVAGE EXISTING MECHANICAL AND SPRINKLER COMPONENTS FOR REINSTALLATION IN NEW LOCATION AND CONNECT TO EXISTING INFRASTRUCTURE. PROVIDE WOOD BLOCKING FOR INSTALLATION OF NEW LIGHT FIXTURES.	
2.15	TEMPORARILY REMOVE EXISTING ACOUSTICAL CEILING TILE FOR INSTALLATION OF NEW LIGHTING. PROVIDE BLOCKING AS REQUIRED AND REINSTALL TILES.	
2.16	EXISTING LIGHT STRIP TO REMAIN AND BE PROTECTED THROUGHOUT THE DURATION OF CONSTRUCTION.	
2.17	PATCH AND PREPARE FOR A NEW COAT OF PAINT.	
2.18	EXISTING HANGING SIGNAGE TO REMAIN AND TO BE PROTECTED THROUGHOUT THE DURATION OF CONSTRUCTION.	
2.19	TEMPORARILY REMOVE EXISTING ACOUSTICAL CEILING SYSTEM AS REQUIRED FOR DEMOLISH OF EXISTING WALL. TEMPORARILY REMOVE EXISTING SECURITY CAMERA AND LIGHT FIXTURES AS REQUIRED AND REINSTALLED EXISTING LOCATION.	
2.20	REMOVE EXISTING GYP. BRD. OFF BOTTOM OF SOFFIT. PATCH AND PAINT NEW GYP. BRD. MATCHING EXISTING THICKNESS.	
2.21	TEMPORARILY REMOVE EXISTING ACOUSTICAL CEILING PANEL SYSTEM TO PREPARE FOR NEW CONSTRUCTION. EXISTING MECHANICAL COMPONENTS AND LIGHT FIXTURES TO BE REMOVED AND SALVAGED FOR REINSTALLATION. MECHANICAL COMPONENTS TO BE RELOCATED TO NEW LOCATION. REINSTALL EXISTING ACOUSTICAL CEILING SYSTEM ONCE NEW WORK HAS BEEN COMPLETED.	
2.22	REMOVE AND SALVAGE EXISTING SECURITY CAMERA FOR REINSTALLATION.	
2.23	EXISTING SPRINKLER TO BE CENTERED IN NEW ACOUSTICAL CEILING TILE.	
2.24	PATCH AND PREPARE SOFFIT FOR A NEW COAT OF PAINT. PAINT UP TO ACOUSTICAL CEILING LINE.	
2.25	CUT OUT 1X1 SECTION OUT OF EXISTING GY. BRD. SOFFIT TO REMOVE EXISTING TEST SWITCH IN ITS ENTIRETY. INSTALL 1X1 ACCESS PANEL. PATCH AND REPAIR EXISTING GYP. BRD. CEILING TO PREPARE FOR NEW CONSTRUCTION.	
2.26	TEMPORARILY REMOVE EXISTING ACOUSTICAL CEILING PANEL SYSTEM TO PREPARE FOR NEW CONSTRUCTION. EXISTING MECHANICAL COMPONENTS, LIGHT FIXTURES SPRINKLERS AND SPRINKLERSTO BE REMOVED AND SALVAGED FOR REINSTALLATION. MECHANICAL COMPONENTS TO BE RELOCATED TO NEW LOCATION. REINSTALL EXISTING ACOUSTICAL CEILING SYSTEM ONCE NEW WORK HAS BEEN COMPLETED.	

NO	ISSUE	DATE
1	Bid Set	06/16/2025
	Addendum 1	06/30/2025

MAIN LEVEL
DEMOLITION
PLAN - YOUTH

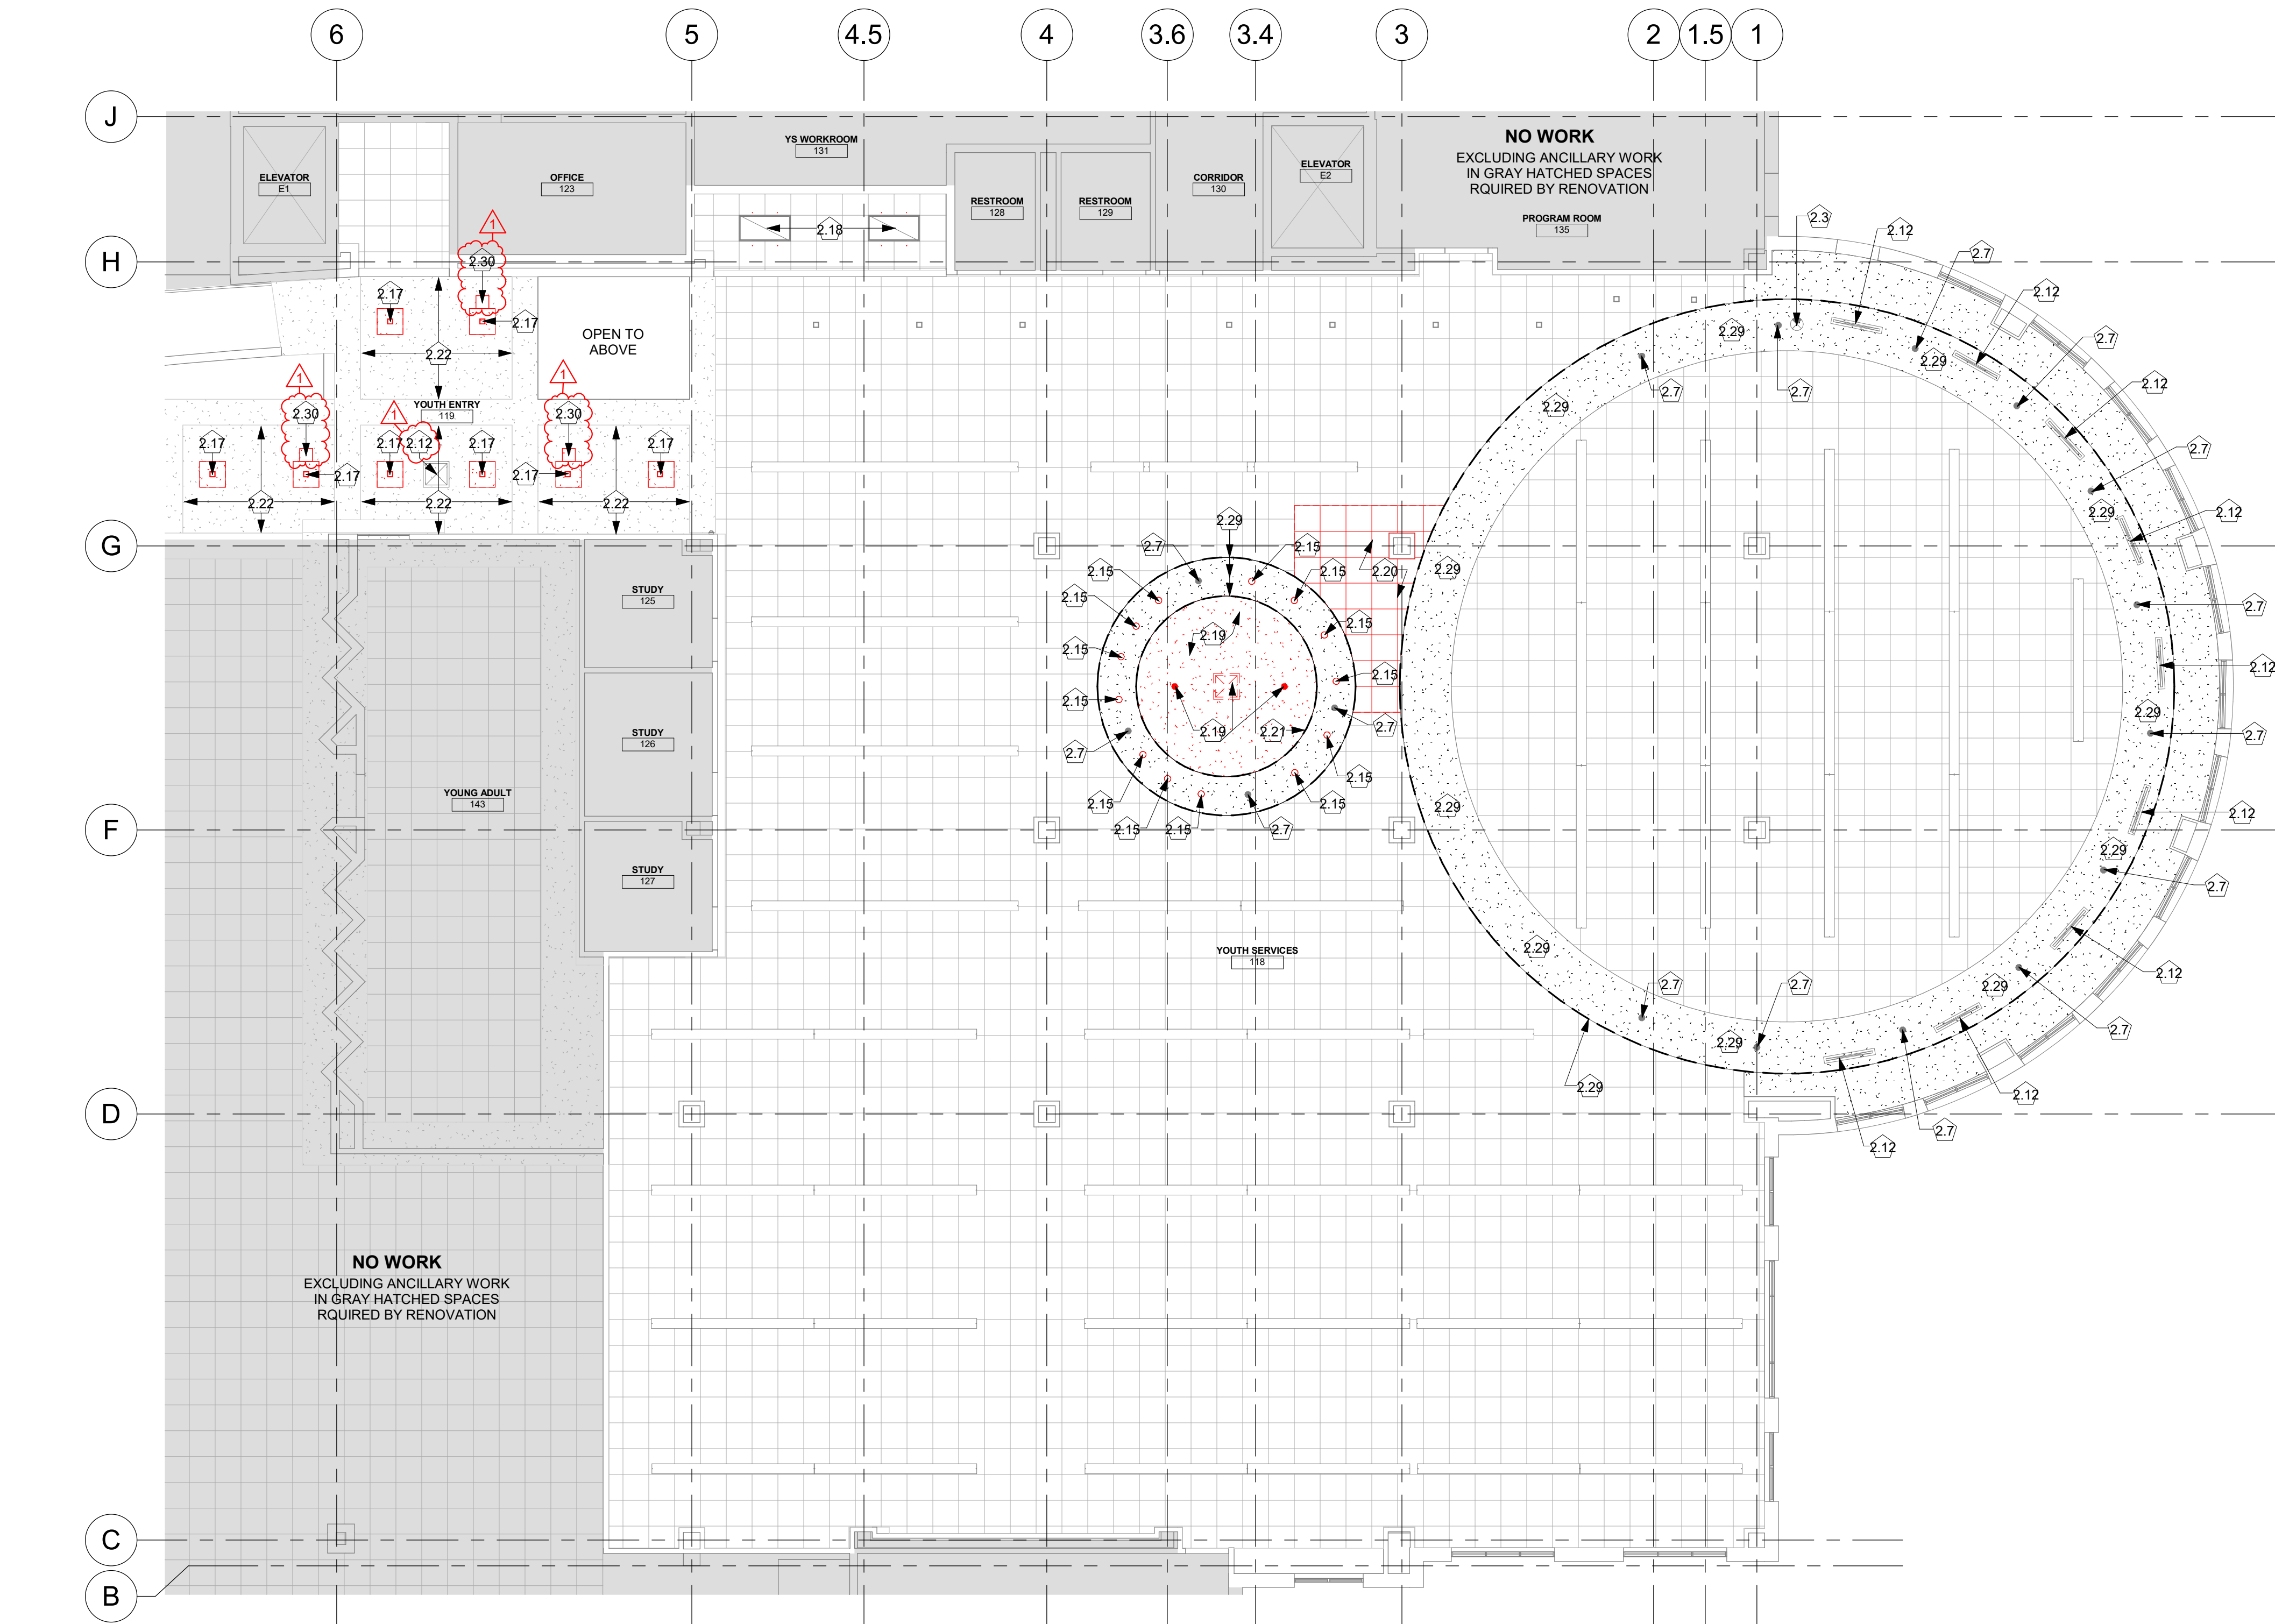

1 FIRST FLOOR - DEMO RCP - YOUTH
1/8" = 1'-0"

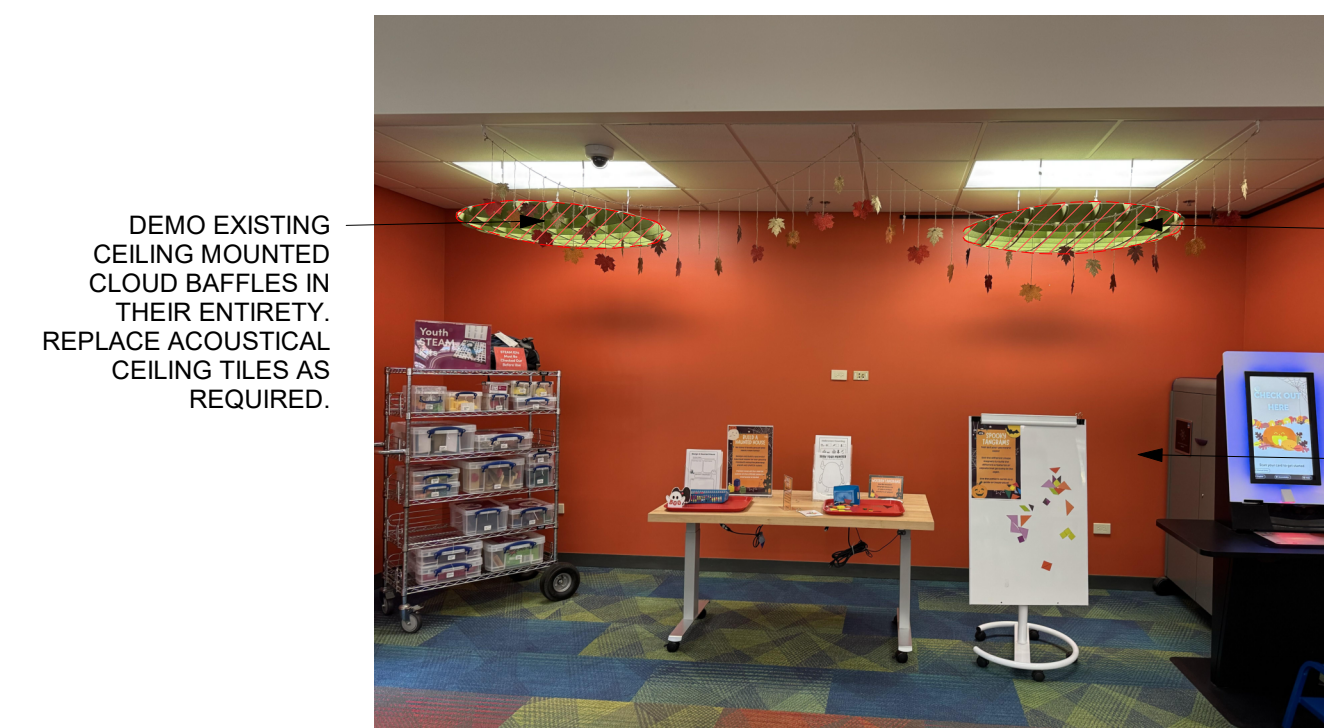

DEMO EXISTING
CEILING MOUNTED
CLOUD BAFFLES IN
THEIR ENTIRETY.
REPLACE ACOUSTICAL
CEILING TILES AS
REQUIRED.

DEMO EXISTING CEILING
MOUNTED CLOUD
BAFFLES IN THEIR
ENTIRETY. REPLACE
ACOUSTICAL CEILING
TILES AS REQUIRED.

PATCH AND PREPARE
FOR NEW COAT OF
PAINT

YOUTH SERVICES - DEMO CEILING BAFFLES
N.T.S.

DEMOLITION LEGEND		
	WALL PARTITION TO BE REMOVED.	
	ITEM TO BE REMOVED	
	PORTION OF AREA TO BE REMOVED. COORDINATE EXACT EXTENDS WITH NEW WORK PLANS	

DEMOLITION PLAN KEY NOTES		
1.0	DEMOLISH EXISTING COUNTERTOP, CASEWORK, FILLERS AND ASSOCIATED FASTENERS IN THEIR ENTIRETY. PATCH EXISTING ADJACENT WALL AND/OR FINISHED FLOOR WITH OWNER'S ATTIC STOCK TO PREPARE FOR NEW CONSTRUCTION.	
1.1	DEMOLISH EXISTING FRAMED GYP. BD. PARTITION IN ITS ENTIRETY. REMOVE AND SALVAGE EXISTING BUILDING COMPONENTS FOR REINSTALLATION IN NEW LOCATION PER CODE REQUIREMENTS. PATCH AND REPAIR EXISTING ADJACENT SURFACES TO PREPARE FOR NEW CONSTRUCTION.	
1.2	REMOVE AND SALVAGE EXISTING GLASS DISPLAY FOR REUSE. SEE NEW PLAN ON SHEET A1.00 FOR NEW LOCATION.	
1.3	EXISTING SHELVING AND SLATWALL TO REMAIN AND TO BE PROTECTED THROUGHOUT THE DURATION OF CONSTRUCTION.	
1.4	EXISTING WATER FOUNTAIN TO REMAIN AND TO BE PROTECTED THROUGHOUT THE DURATION OF CONSTRUCTION.	
1.5	REMOVE EXISTING WALLPAPER AND ADHESIVE IN ITS ENTIRETY. PATCH AND REPAIR WALL TO PREPARE FOR NEW CONSTRUCTION. SKIMCOAT ENTIRE SURFACE OF WALL AFTER WALLPAPER HAS BEEN REMOVED.	
1.6	DEMOLISH EXISTING SERVICE DESK IN ITS ENTIRETY. PATCH AND REPAIR EXISTING ADJACENT SURFACES AND FINISHED FLOOR TO PREPARE FOR NEW CONSTRUCTION.	
1.7	EXISTING INTERIOR TREES TO REMAIN AND TO BE PROTECTED THROUGHOUT THE DURATION OF CONSTRUCTION.	
1.8	DEMOLISH PORTION OF EXISTING FRAMED WALL INCLUDING TILE, TILE BASE, AND ALL ASSOCIATED BUILDING SYSTEM COMPONENTS IN THEIR ENTIRETY. REMOVE ELECTRICAL CONDUIT/WIRING BACK TO ASSOCIATED PANEL. PATCH ALL ADJACENT SURFACES AND SUBFLOOR TO PREPARE FOR NEW CONSTRUCTION.	
1.9	EXISTING SECURITY GATES TO REMAIN AND TO BE PROTECTED THROUGHOUT THE DURATION OF CONSTRUCTION.	
1.10	EXISTING FLOOR MOUNTED BASEBOARD HEATER AND ALL ASSOCIATED COMPONENTS TO REMAIN AND BE PROTECTED THROUGHOUT THE DURATION OF CONSTRUCTION.	
1.11	REMOVE AND SALVAGE EXISTING SLATWALL DISPLAY AND SIGNAGE. RETURN TO OWNER.	
1.12	EXISTING FIRE CABINET TO REMAIN AND TO BE PROTECTED THROUGHOUT THE DURATION OF CONSTRUCTION.	
1.13	EXISTING GLASS STOREFRONT TO REMAIN AND TO BE PROTECTED THROUGHOUT THE DURATION OF CONSTRUCTION.	
1.14	PATCH AND PREPARE FOR NEW COAT OF PAINT.	
1.15	REMOVE AND SALVAGE EXISTING MONITOR AND RETURN TO OWNER.	
1.16	REMOVE AND SALVAGE EXISTING SIGNAGE AND RETURN TO OWNER.	
1.17	REMOVE EXISTING CONCRETE SLAB TO ACCOMMODATE NEW FLOOR BOX AND CONDUIT RUN. PATCH AND REPAIR FLOOR SLAB AS REQUIRED TO PREPARE FOR NEW CONSTRUCTION. EXACT FLOORBOX LOCATION TO BE FINALIZED WITH FINAL DESK SHOP DRAWINGS.	
1.18	CONTRACTOR TO REMOVE EXISTING CARPET TILE IN ORDER TO PERFORM NEW ELECTRICAL WORK. SALVAGE FULL CARPET TILES FOR REINSTALLATION.	
1.19	CUT OUT SECTION OF EXISTING GYP. BRD. TO INSTALL WOOD BLOCKING FOR INSTALLATION OF NEW ELECTRICAL WORK AND INSTALLATION OF NEW SHELVING. PATCH AND PAINT NEW GYP. BRD. MATCHING EXISTING THICKNESS. SEE DEMO ELEVATIONS FOR ADDITIONAL INFORMATION.	
1.20	CUT OUT SECTION OF EXISTING GYP. BRD. TO INSTALL WOOD BLOCKING FOR INSTALLATION OF NEW SHELVING. PATCH AND PAINT NEW GYP. BRD. MATCHING EXISTING THICKNESS. SEE DEMO ELEVATIONS FOR ADDITIONAL INFORMATION.	
1.21	REMOVE EXISTING TILE PIECES IN THIS AREA. ONLY REMOVE TILE PIECES THAT ARE A PARTIAL TILES TO ALLOW FOR INSTALL OF FULL TILES AFTER REMOVAL OF WALL.	
1.21	REMOVE EXISTING TILE PIECES IN THIS AREA. ONLY REMOVE TILE PIECES THAT ARE B PARTIAL TILES TO ALLOW FOR INSTALL OF FULL TILES AFTER REMOVAL OF SERVICE DESK.	
1.21	REMOVE EXISTING CARPET PIECES IN THIS AREA. ONLY REMOVE TILE PIECES THAT C ARE PARTIAL CARPET TILES TO ALLOW FOR INSTALL OF FULL CARPET TILES AFTER REMOVAL OF WALL.	
1.22	REMOVE EXISTING GYP. BRD. IN ITS ENTIRETY AND INSTALL TILE BACKER. PATCH AND PREPARE FOR NEW CONSTRUCTION.	
2.0	DEMOLISH PORTION OF EXISTING ACOUSTICAL PANEL CEILING SYSTEM INCLUDING BUT NOT LIMITED TO ALL ASSOCIATED HANGERS, ANCHOR CLIPS, T-GRID IN AREA TO STRUCTURE ABOVE. SEE DEMO ELEVATIONS FOR ADDITIONAL INFORMATION.	
2.1	REMOVE AND SALVAGE EXISTING SMOKE DETECTOR INCLUDING ALL ASSOCIATED HANGERS AND ANCHOR CLIPS. REINSTALL IN NEW LOCATION.	
2.2	DEMOLISH LIGHT FIXTURE IN ITS ENTIRETY. INCLUDING BUT NOT LIMITED TO STRUCTURE ABOVE. SEE DEMO ELEVATIONS FOR ADDITIONAL INFORMATION.	
2.3	EXISTING EXIT SIGN TO REMAIN AND BE PROTECTED THROUGHOUT THE DURATION OF THE CONSTRUCTION.	
2.4	EXISTING LIGHT FIXTURE TO REMAIN AND BE PROTECTED THROUGHOUT THE DURATION OF THE CONSTRUCTION.	
2.5	EXISTING SECURITY CAMERA TO REMAIN AND BE PROTECTED THROUGHOUT THE DURATION OF THE CONSTRUCTION.	
2.6	NOT IN USE.	
2.7	EXISTING SPRINKLER HEAD TO REMAIN AND BE PROTECTED THROUGHOUT THE DURATION OF THE CONSTRUCTION.	
2.8	EXISTING PORTION OF ACOUSTICAL PANEL CEILING SYSTEM TO REMAIN AND BE PROTECTED THROUGHOUT THE DURATION OF THE CONSTRUCTION.	
2.9	EXISTING GYP. BOARD CEILING TO REMAIN AND BE PROTECTED THROUGHOUT THE DURATION OF THE CONSTRUCTION.	
2.10	EXISTING OVERHEAD COILING SECURITY GATE TO REMAIN AND TO BE PROTECTED THROUGHOUT THE DURATION OF CONSTRUCTION.	
2.11	NOT IN USE.	
2.12	EXISTING MECHANICAL GRILLE COMPONENTS TO REMAIN AND BE PROTECTED THROUGHOUT THE DURATION OF THE CONSTRUCTION.	
2.13	REMOVE AND SALVAGE EXISTING MECHANICAL GRILLE COMPONENT AND REINSTALL IN NEW LOCATION.	
2.14	EXISTING GYP. BOARD SOFFIT TO REMAIN. PATCH AND REPAIR TO PREPARE FOR NEW CONSTRUCTION.	
2.15	DEMOLISH EXISTING LIGHT FIXTURE IN ITS ENTIRETY BACK TO NEAREST JUNCTION BOX.	
2.16	DISCONNECT AND REMOVE EXISTING LIGHT FIXTURE. ALL EXISTING WIRING TO REMAIN AND TO EXTEND TO MAKE NEW CONNECTION WITH NEW WALL SCONCE LIGHTING. RETURN ALL EXISTING LIGHTING TO OWNER.	
2.17	CUT OUT 2'X2' SECTION OUT OF EXISTING GY. BRD. SOFFIT TO REMOVE EXISTING LIGHT FIXTURE IN ITS ENTIRETY. PATCH AND PAINT NEW GYP. BRD. MATCHING EXISTING THICKNESS.	
2.18	DEMOLISH EXISTING CEILING MOUNTED BAFFLE IN ITS ENTIRETY. REPLACE EXISTING ACOUSTICAL CEILING TILES AS REQUIRED.	
2.19	DEMOLISH EXISTING GYP. BRD. EXISTING FRAMING TO REMAIN. SALVAGE EXISTING MECHANICAL AND SPRINKLER COMPONENTS FOR REINSTALLATION IN NEW LOCATION AND CONNECT TO EXISTING INFRASTRUCTURE. PROVIDE WOOD BLOCKING FOR INSTALLATION OF NEW LIGHT FIXTURES.	
2.20	TEMPORARILY REMOVE ACOUSTICAL CEILING TILE FOR INSTALLATION OF NEW LIGHTING. PROVIDE BLOCKING AS REQUIRED AND REINSTALL TILES.	
2.21	EXISTING LIGHT STRIP TO REMAIN AND BE PROTECTED THROUGHOUT THE DURATION OF CONSTRUCTION.	
2.22	PATCH AND PREPARE FOR A NEW COAT OF PAINT.	
2.23	EXISTING HANGING SIGNAGE TO REMAIN AND TO BE PROTECTED THROUGHOUT THE DURATION OF CONSTRUCTION.	
2.24	TEMPORARILY REMOVE. REPLACE EXISTING ACOUSTICAL CEILING SYSTEM AS REQUIRED FOR DEMOLISH OF EXISTING WALL. TEMPORARILY REMOVE EXISTING SECURITY CAMERA AND LIGHT FIXTURES AS REQUIRED AND REINSTALLED EXISTING LOCATION.	
2.25	REMOVE EXISTING GYP. BRD. OFF BOTTOM OF SOFFIT. PATCH AND PAINT NEW GYP. BRD. MATCHING EXISTING THICKNESS.	
2.26	TEMPORARILY REMOVE EXISTING ACOUSTICAL CEILING PANEL SYSTEM TO PREPARE FOR NEW CONSTRUCTION. EXISTING MECHANICAL COMPONENTS AND LIGHT FIXTURES TO BE REMOVED AND SALVAGED FOR REINSTALLATION. MECHANICAL COMPONENTS TO BE RELOCATED TO NEW LOCATION. REINSTALL EXISTING ACOUSTICAL CEILING SYSTEM ONCE NEW WORK HAS BEEN COMPLETED.	
2.27	REMOVE AND SALVAGE EXISTING SECURITY CAMERA FOR REINSTALLATION.	
2.28	EXISTING SPRINKLER TO BE CENTERED IN NEW ACOUSTICAL CEILING TILE.	
2.29	PATCH AND PREPARE SOFFIT FOR A NEW COAT OF PAINT. PAINT UP TO ACOUSTICAL CEILING LINE.	
2.30	CUT OUT 1'X1' SECTION OUT OF EXISTING GY. BRD. SOFFIT TO REMOVE EXISTING TEST SWITCH IN ITS ENTIRETY. INSTALL 1'X1' ACCESS PANEL. PATCH AND REPAIR EXISTING GYP. BRD. CEILING TO PREPARE FOR NEW CONSTRUCTION.	
2.31	TEMPORARILY REMOVE EXISTING ACOUSTICAL CEILING PANEL SYSTEM TO PREPARE FOR NEW CONSTRUCTION. EXISTING MECHANICAL COMPONENTS, LIGHT FIXTURES, SPRINKLERS AND SPEAKERS TO BE REMOVED AND SALVAGED FOR REINSTALLATION. MECHANICAL COMPONENTS TO BE RELOCATED TO NEW LOCATION. REINSTALL EXISTING ACOUSTICAL CEILING SYSTEM ONCE NEW WORK HAS BEEN COMPLETED.	

Glenview Public Library

Glenview Public Library
1930 Glenview Rd. Glenview, IL 60025

NO	ISSUE	DATE
•	Bid Set	06/16/2025
1	Addendum 1	06/30/2025
•		
•		
MAIN LEVEL
DEMOLITION
RCP - YOUTH

AD2.00



Glenview Public Library

Glenview Public Library
1030 Glenview Rd Glenview IL 60025



[illegible]

MAIN LEVEL NEW FLOORPLAN AND RCP - CAFE / LOBBY

25007 **A1.00**

25007


COPYRIGHT 2024, STUDIO GC, INC.

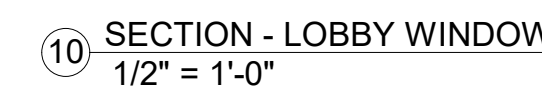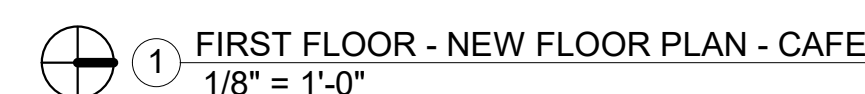


REFLECTED CEILING PLAN SHEET NOTES

- 1 LOCATION OF NEW RECESSED ART RAIL. OWNER PROVIDED AND CONTRACTOR INSTALLED.
- 2 LOCATION OF NEW SIGNAGE. SIGNAGE TO HANG FROM NEW ART RAIL. OWNER PROVIDED AND CONTRACTOR INSTALLED.
- 3 LOCATION OF NEW BLACKBOARD. BLACKBOARD TO HANG FROM NEW ART RAIL. OWNER PROVIDED AND CONTRACTOR INSTALLED.
- 4 NEW LOCATION OF EXISTING SECURITY CAMERA.




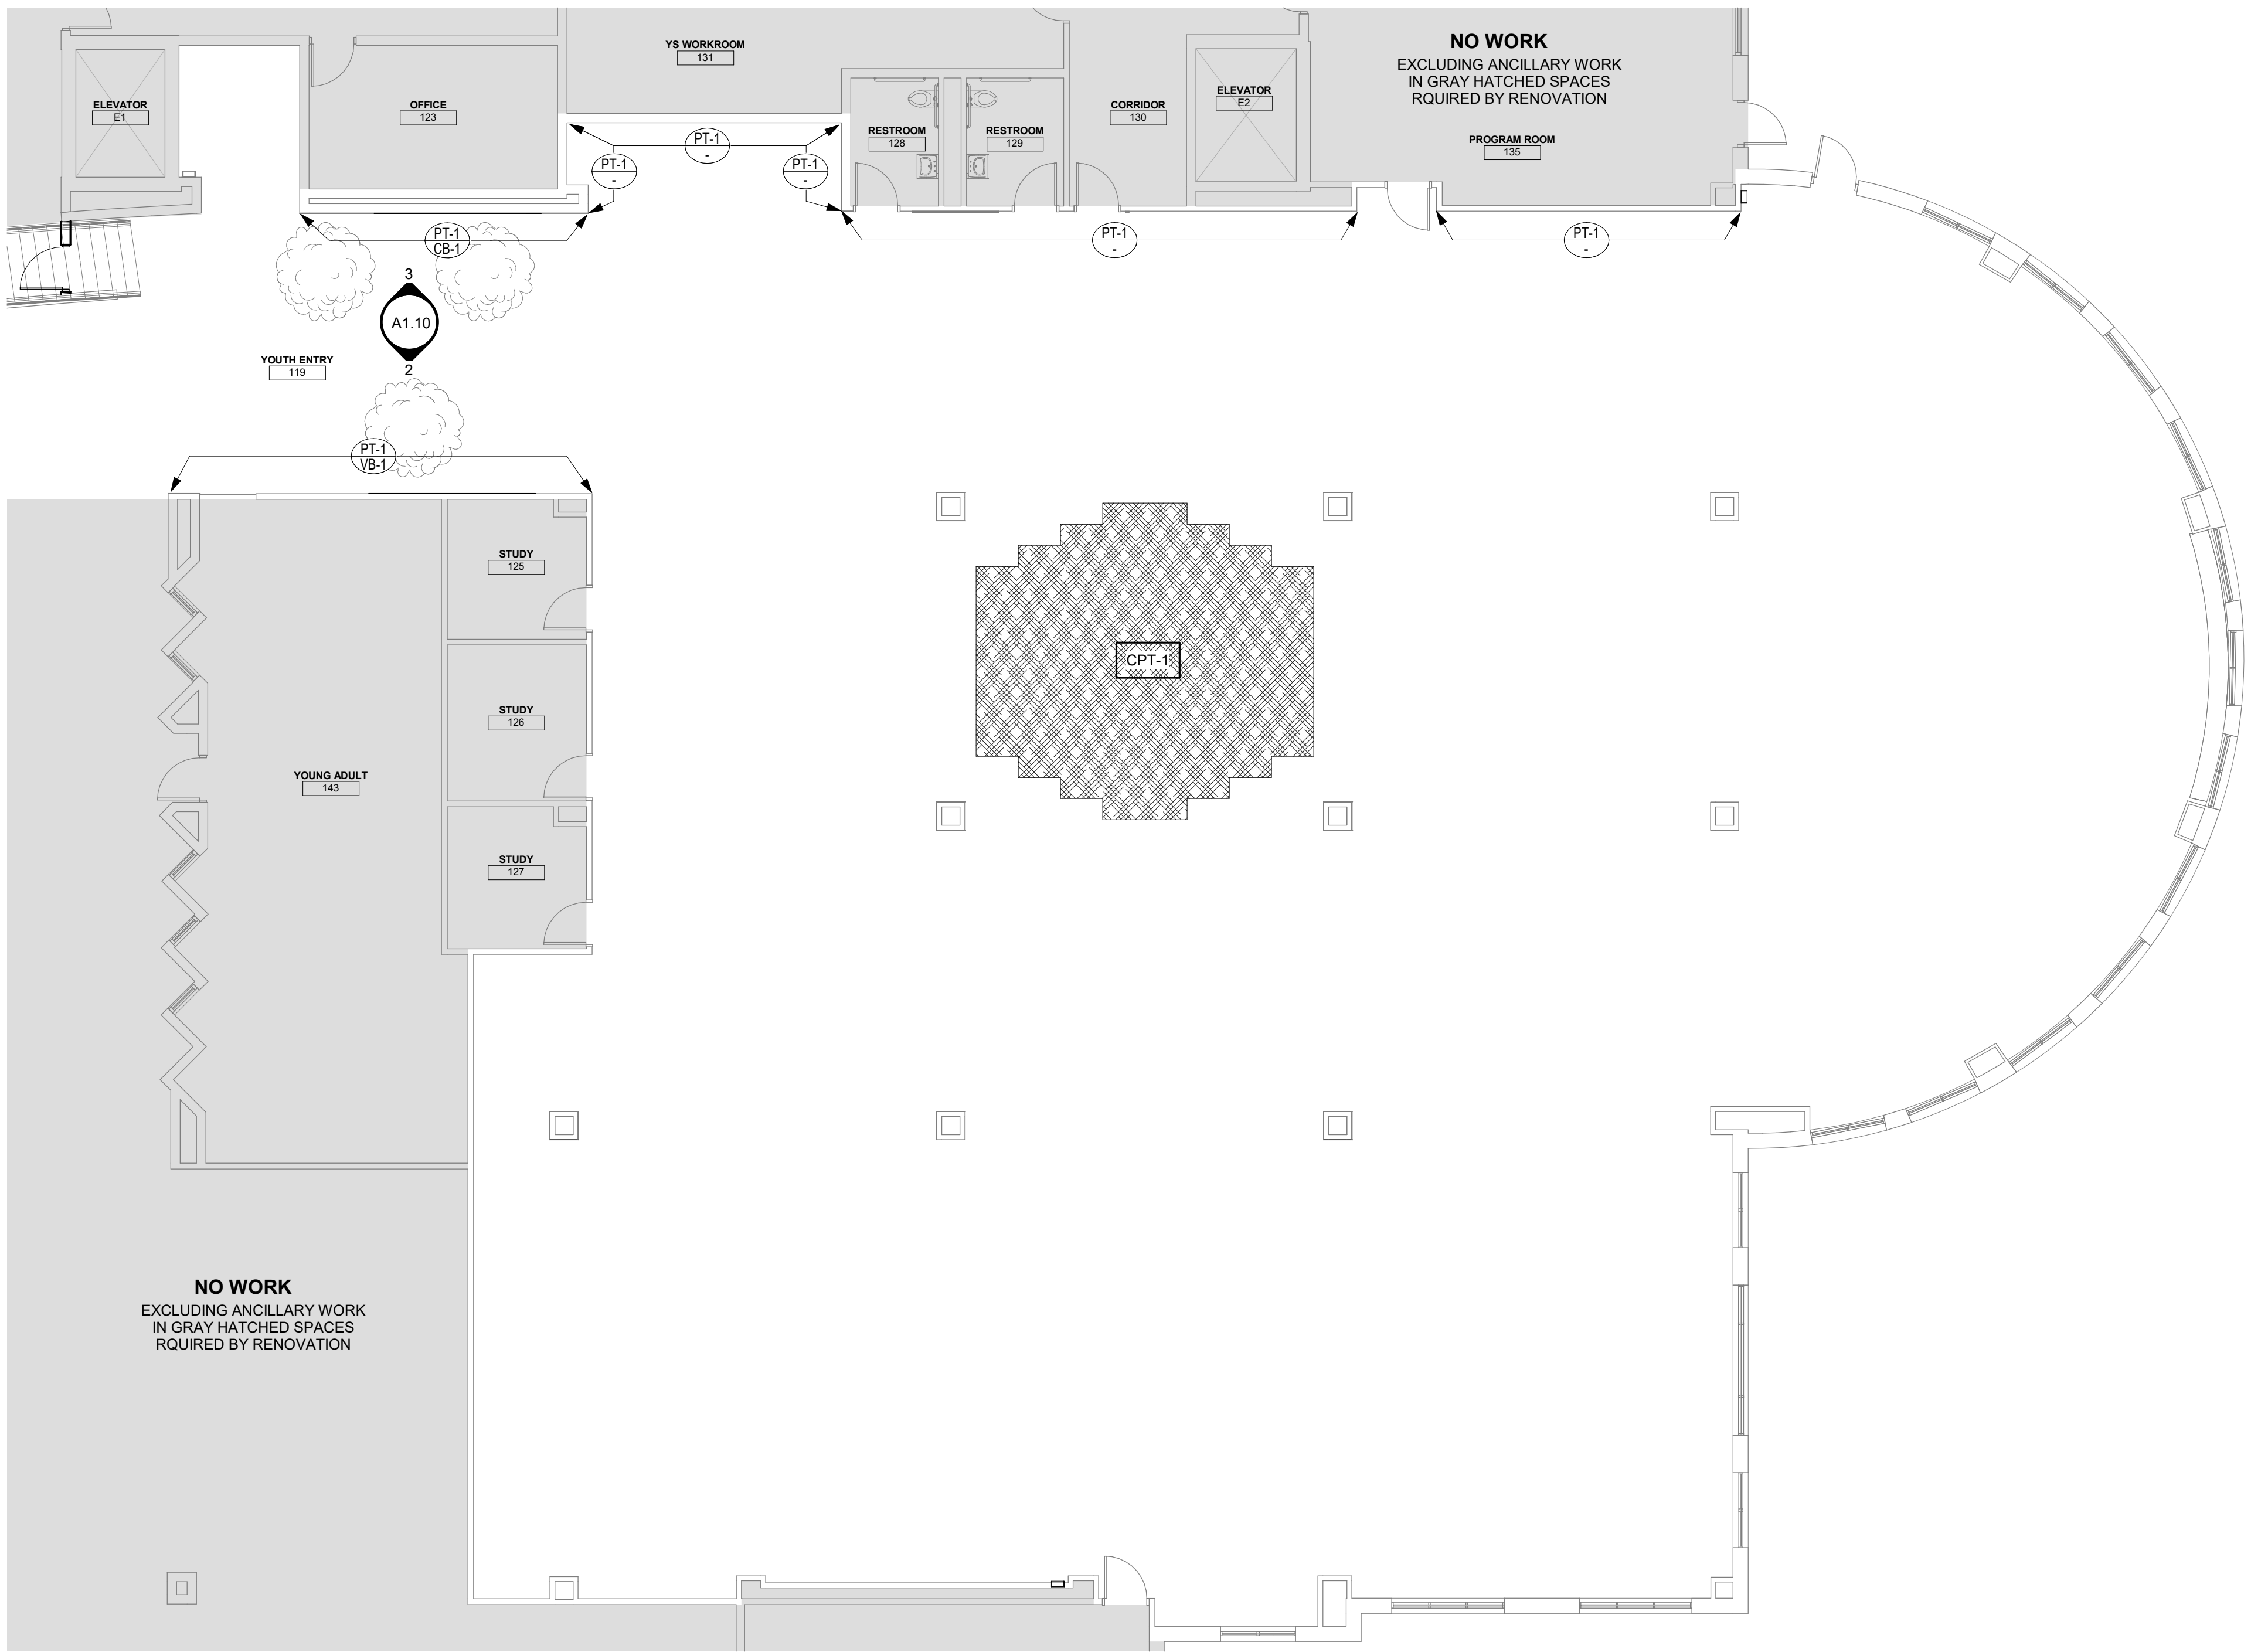

1 FIRST FLOOR - NEW FLOOR PLAN - YOUTH
1/8" = 1'-0"

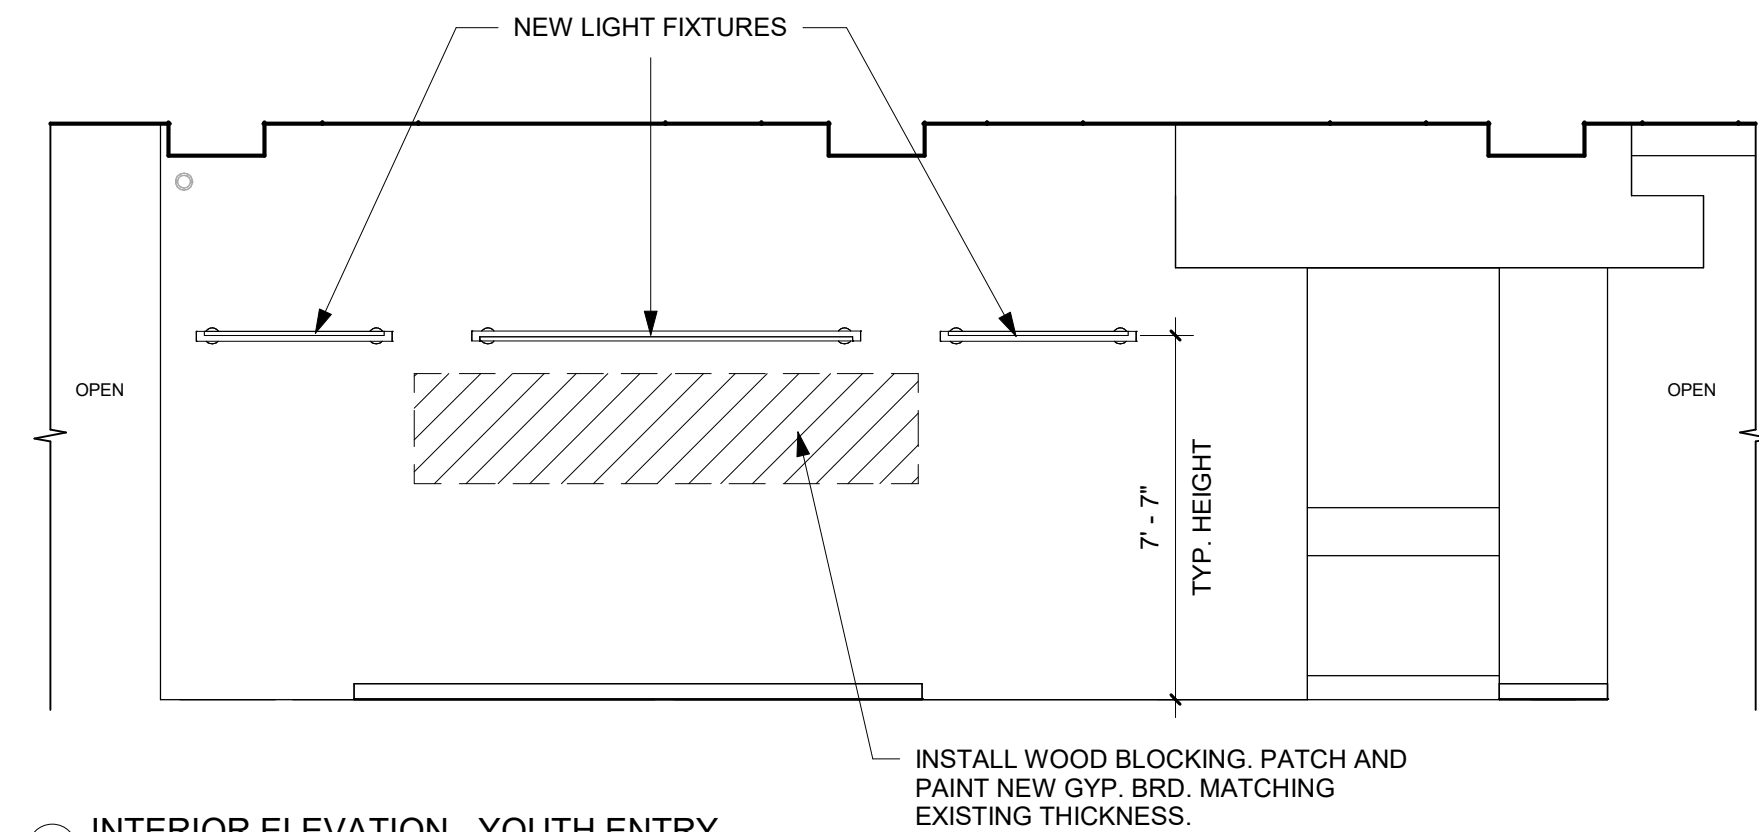

2 INTERIOR ELEVATION - YOUTH ENTRY
1/4" = 1'-0"

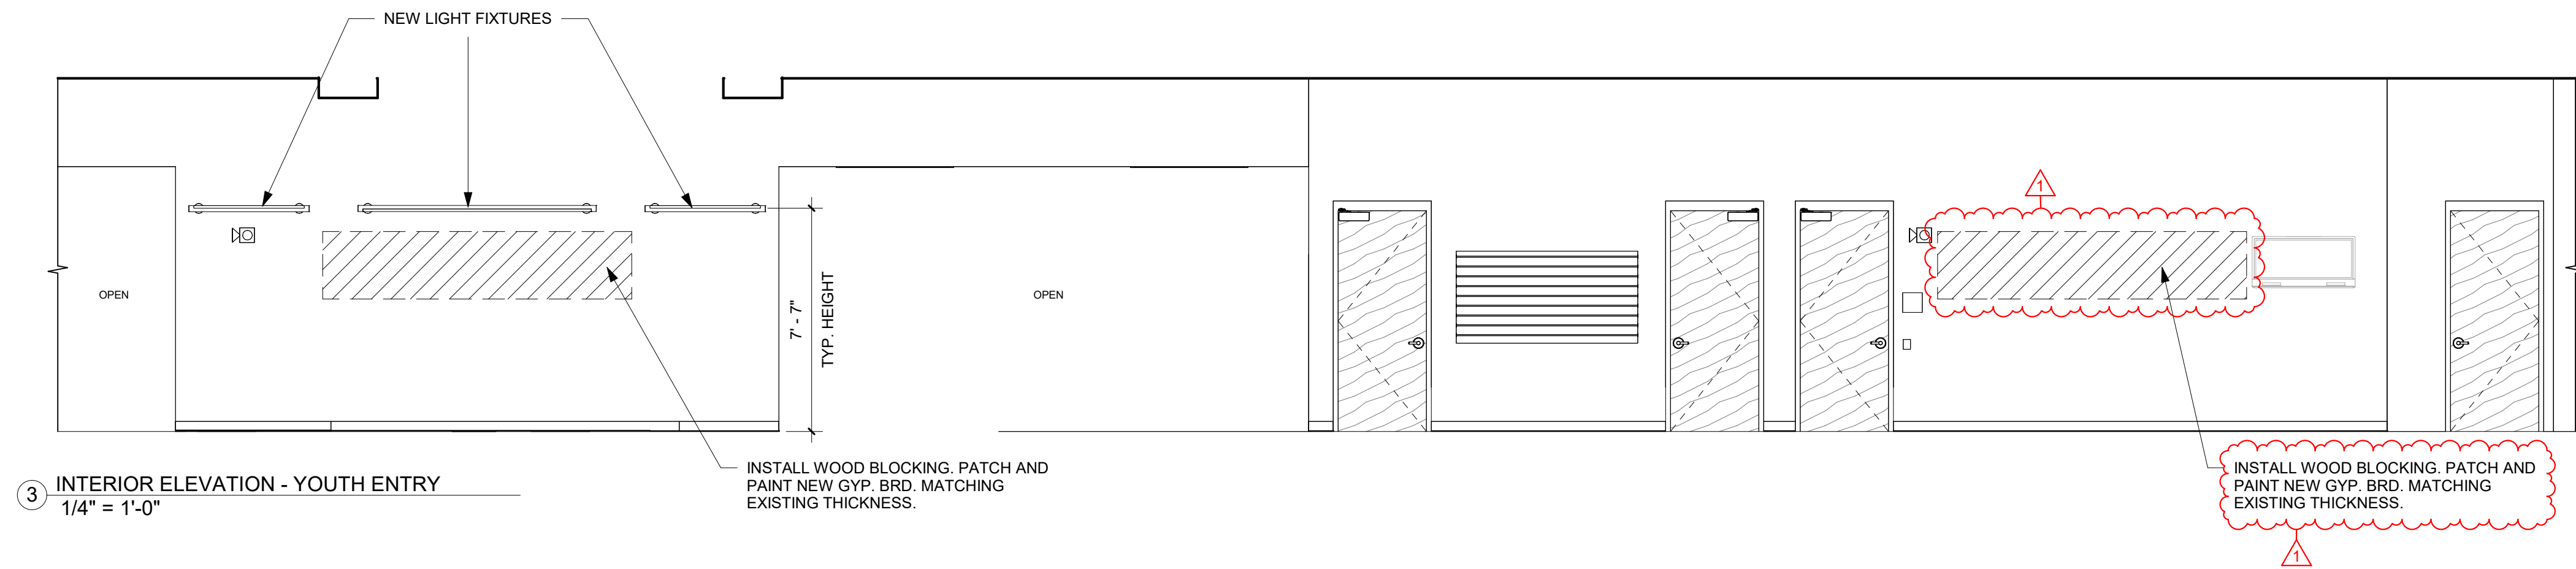

3 INTERIOR ELEVATION - YOUTH ENTRY
1/4" = 1'-0"

FLOOR PLAN LEGEND	
ROOM NAME	ROOM TAG
101	
11	PARTITION TAG
1	NEW WORK SHEET NOTE
○	COLUMN GRID LINE

REFLECTED CEILING PLAN LEGEND:	
CEILING TYPES	
2' x 2' SUSPENDED ACOUSTIC TILE CEILING SYSTEM	
GYPSPUM BOARD CEILING / SOFFIT	

LIGHTING FIXTURES	
RECESSED DOWNLIGHT	
PENDANT	


MECHANICAL SYMBOLS - FOR REFERENCE ONLY	
RETURN DIFFUSER	
SUPPLY DIFFUSER	

MISCELLANEOUS	
SPRINKLER HEAD	

FLOOR PLAN SHEET NOTES	
1	NEW VENDING MACHINE. OWNER PROVIDED AND CONTRACTOR INSTALLED. REFER TO INTERIOR ELEVATIONS.
2	NEW LOCATION OF EXISTING DISPLAY. PROVIDE WOOD BLOCKING AS REQUIRED.

NO	ISSUE	DATE
1	Bid Set	06/16/2025
	Addendum 1	06/30/2025

MAIN LEVEL
NEW
FLOORPLAN -
YOUTH

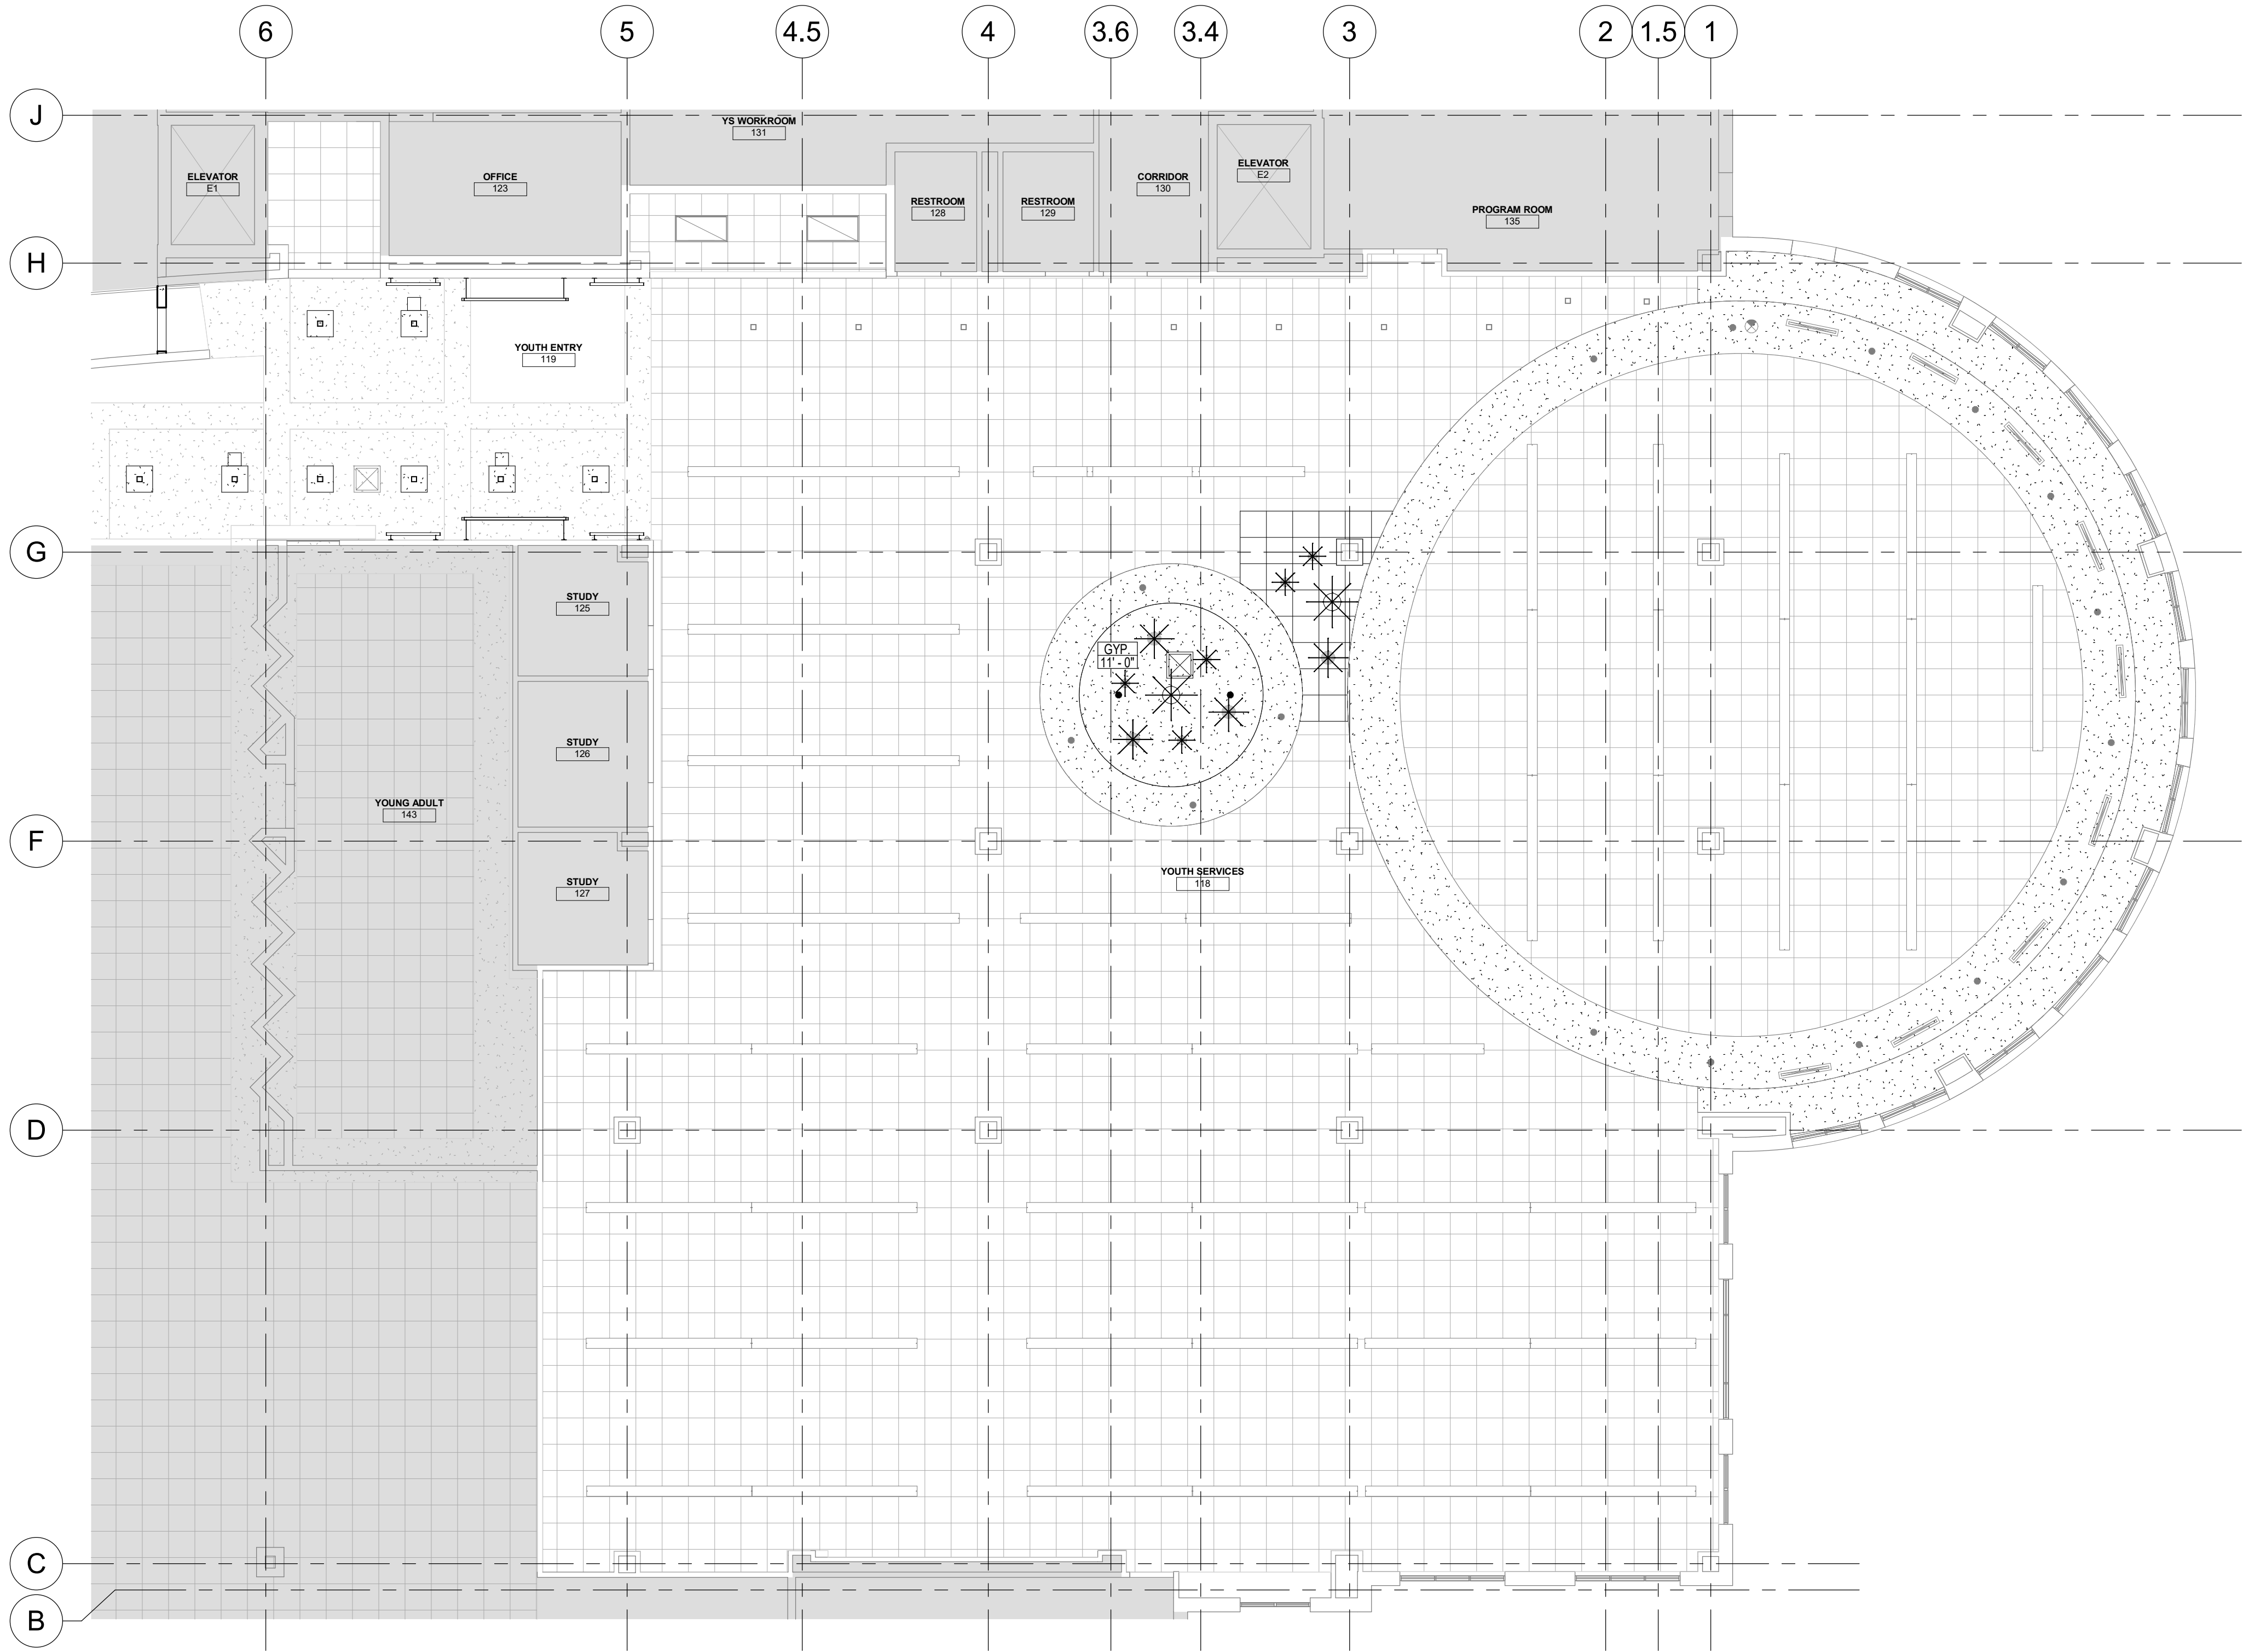

1 FIRST FLOOR - NEW REFLECTED CEILING PLAN - YOUTH
1/8" = 1'-0"

FLOOR PLAN LEGEND

ROOM NAME	ROOM TAG
101	
11	PARTITION TAG
1	NEW WORK SHEET NOTE
○	COLUMN GRID LINE

REFLECTED CEILING PLAN LEGEND:

CEILING TYPES	
	2' x 2' SUSPENDED ACOUSTIC TILE CEILING SYSTEM
	GYPSUM BOARD CEILING / SOFFIT
LIGHTING FIXTURES	
	RECESSED DOWNLIGHT
	PENDANT
MECHANICAL SYMBOLS - FOR REFERENCE ONLY	
	RETURN DIFFUSER
	SUPPLY DIFFUSER
MISCELLANEOUS	
	SPRINKLER HEAD

FLOOR PLAN SHEET NOTES

1 NEW VENDING MACHINE. OWNER PROVIDED AND CONTRACTOR INSTALLED. REFER TO INTERIOR ELEVATIONS.

2 NEW LOCATION OF EXISTING DISPLAY. PROVIDE WOOD BLOCKING AS REQUIRED.



STUDIO GC
architecture + interiors
223 West Jackson Boulevard, Suite 1200
Chicago, Illinois 60606
(312) 253-3400


Glenview Public Library

Glenview Public Library
1930 Glenview Rd, Glenview, IL 60025


NO	ISSUE	DATE
1	Bid Set	06/16/2025
	Addendum 1	06/30/2025

MAIN LEVEL
NEW RCP -
YOUTH

A2.00

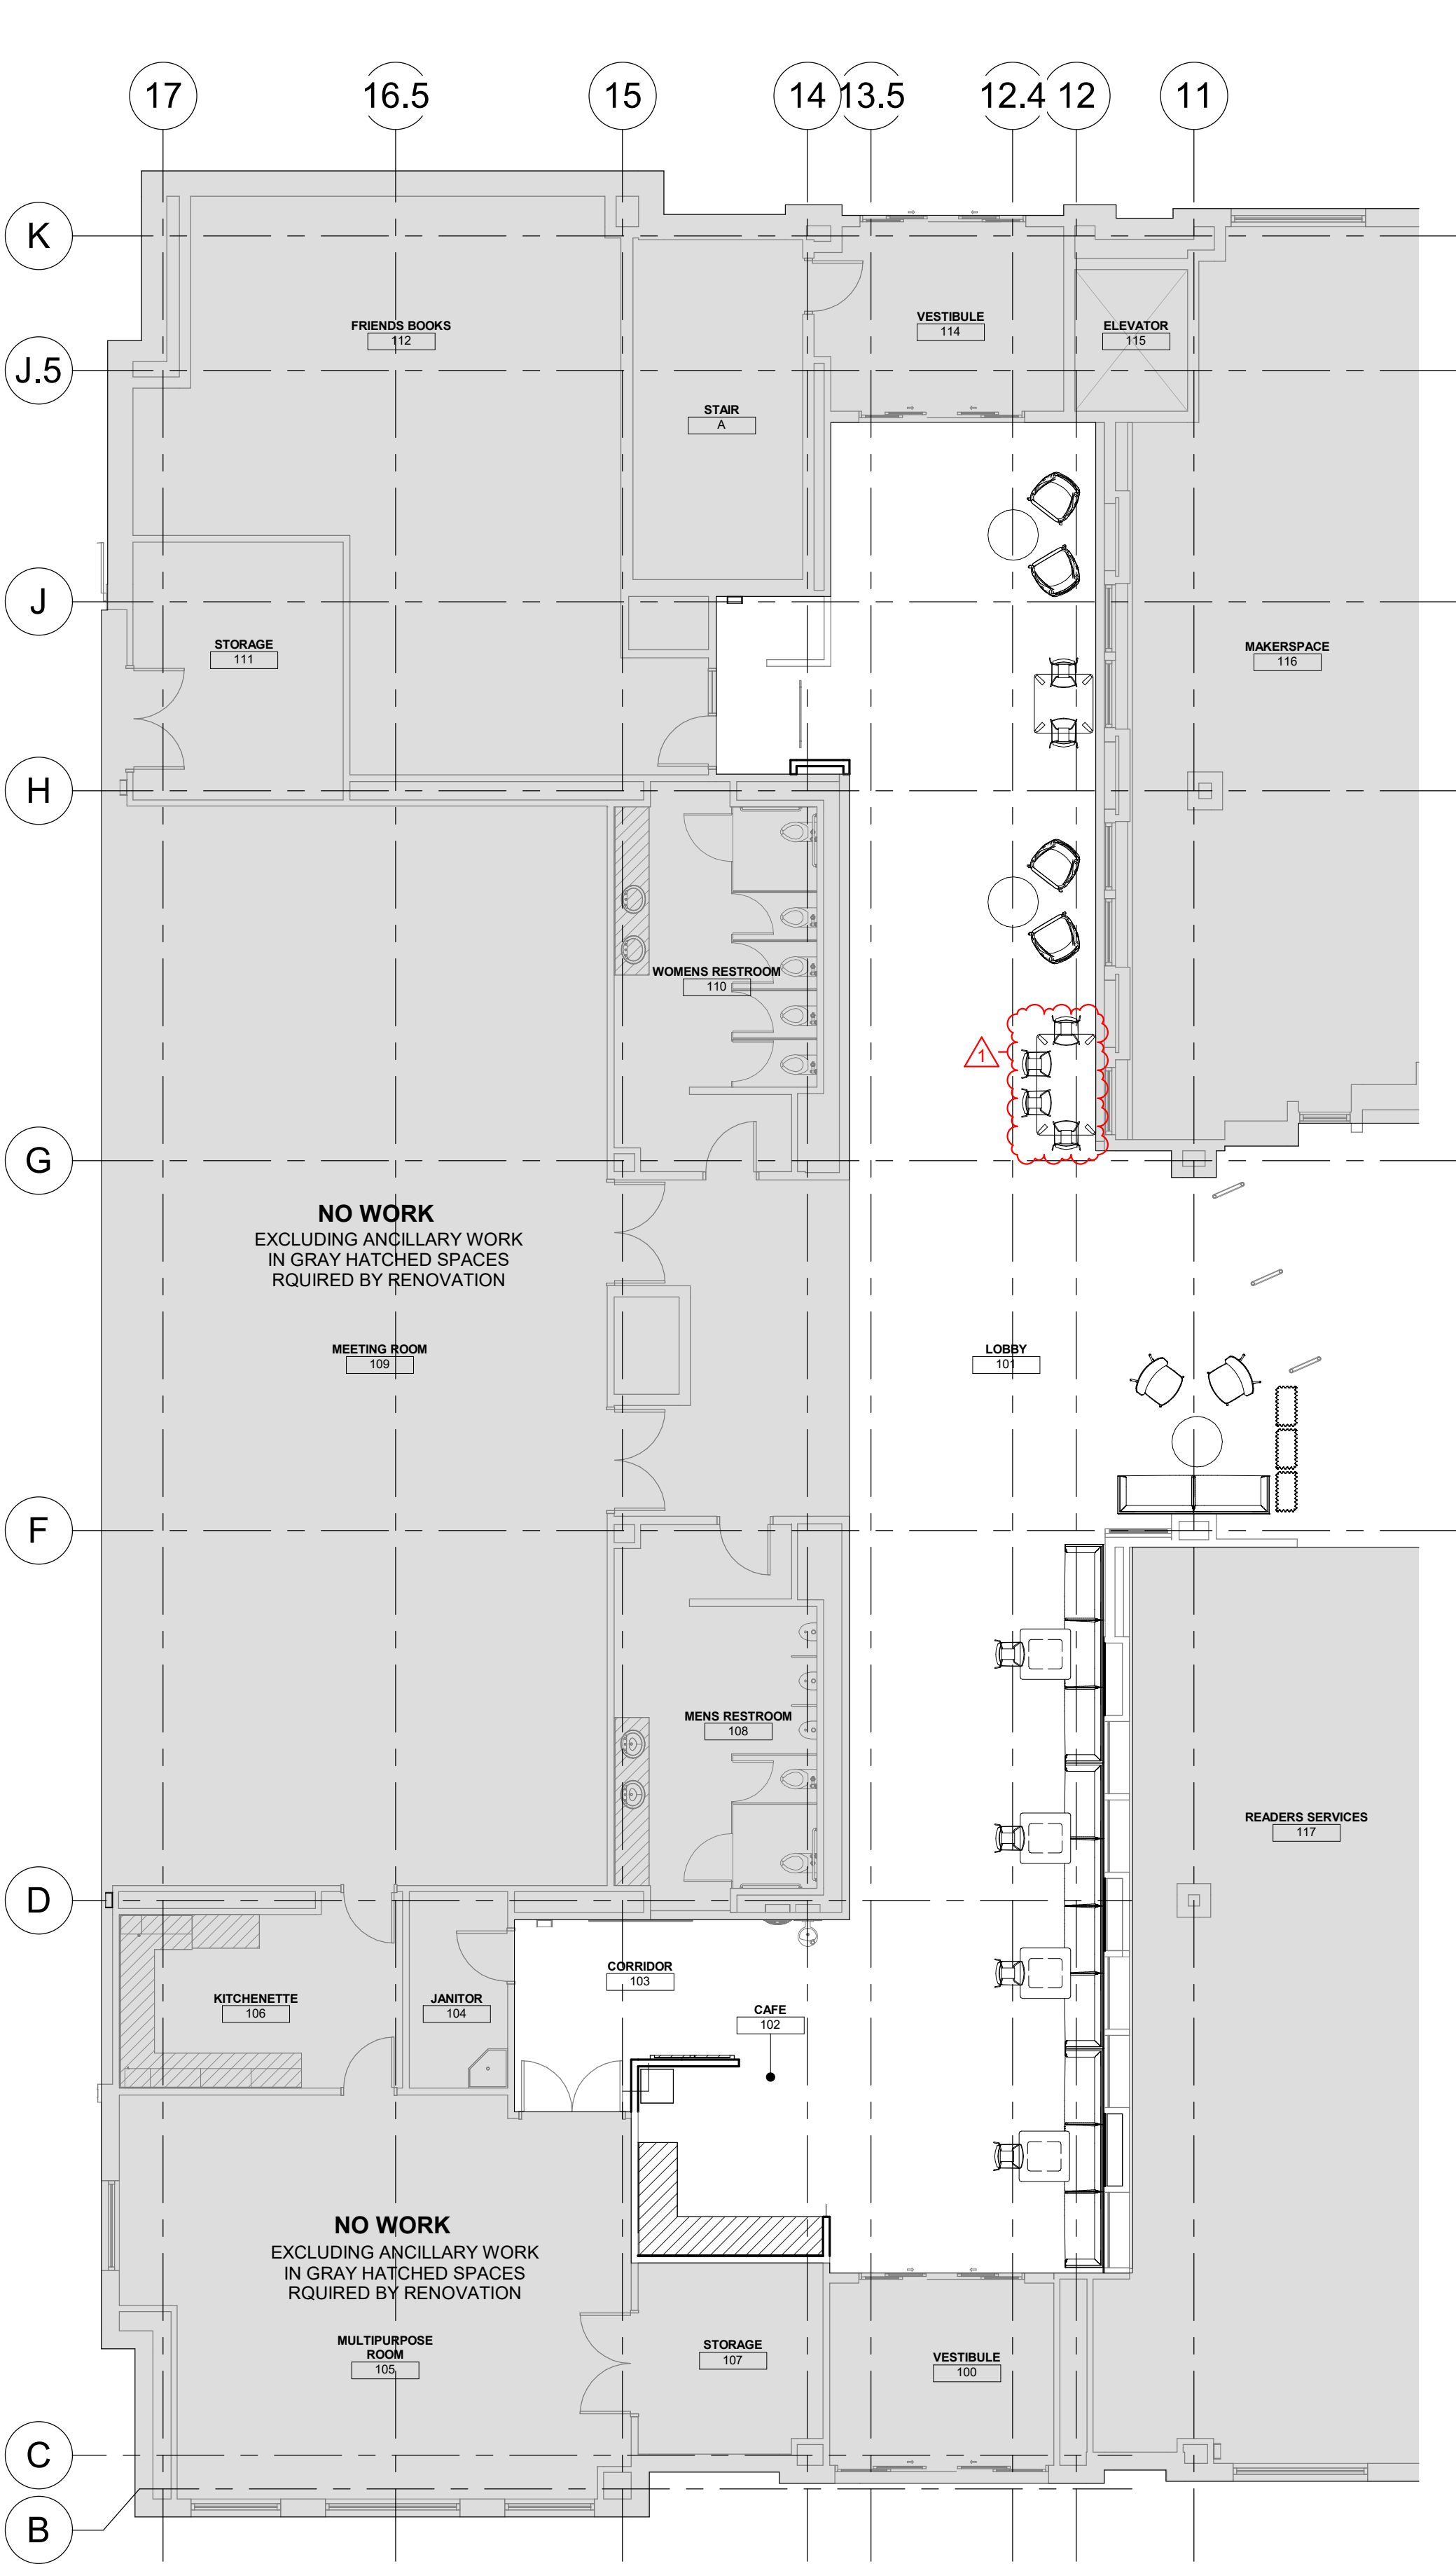

① FIRST FLOOR - NEW FLOOR PLAN - FURNITURE PLAN - FOR REFERENCE ONLY
1/8" = 1'-0"

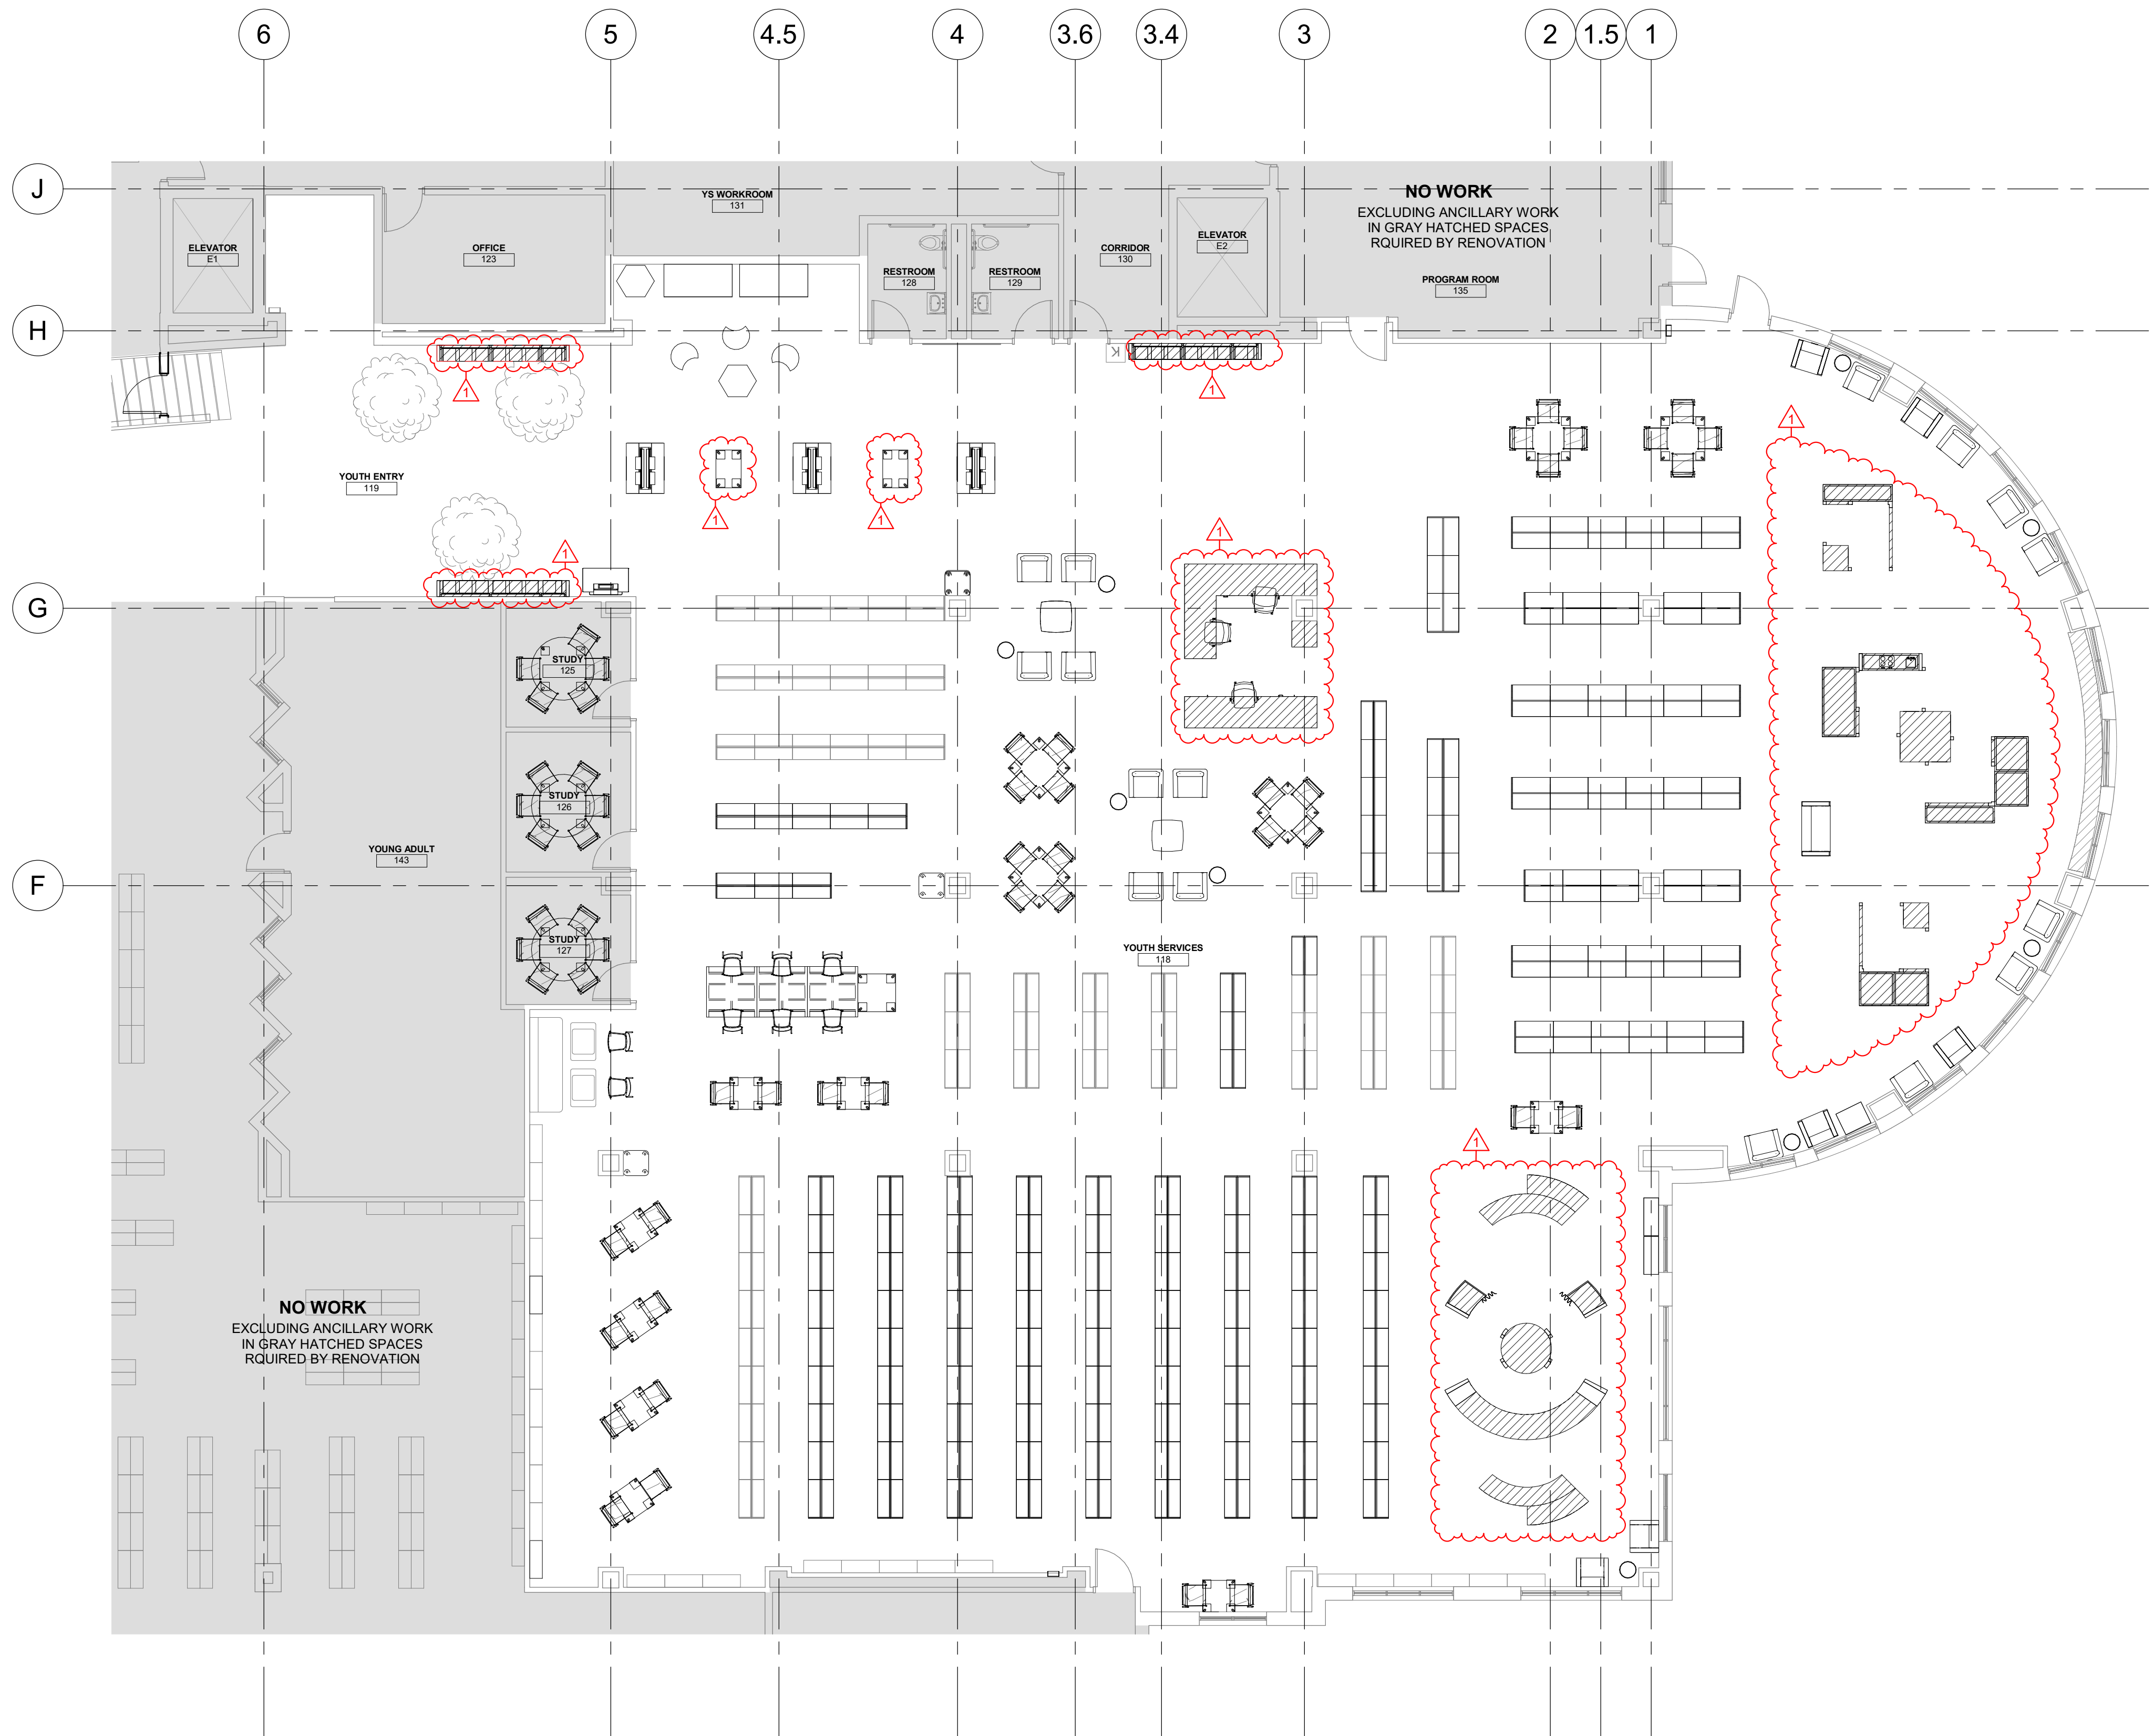

② FIRST FLOOR - NEW FLOOR PLAN - YOUTH - FURNITURE PLAN - FOR REFERENCE ONLY
1/8" = 1'-0"



STUDIO GC
architecture + interiors
223 West Jackson Boulevard, Suite 1200
Chicago, Illinois 60606
(312) 253-3400


Glenview Public Library

Glenview Public Library
1930 Glenview Rd. Glenview, IL 60025


NO	ISSUE	DATE
1	Bid Set	06/16/2025
	Addendum 1	06/30/2025

**FURNITURE
PLAN - FOR
REFERENCE
ONLY**


A4.00

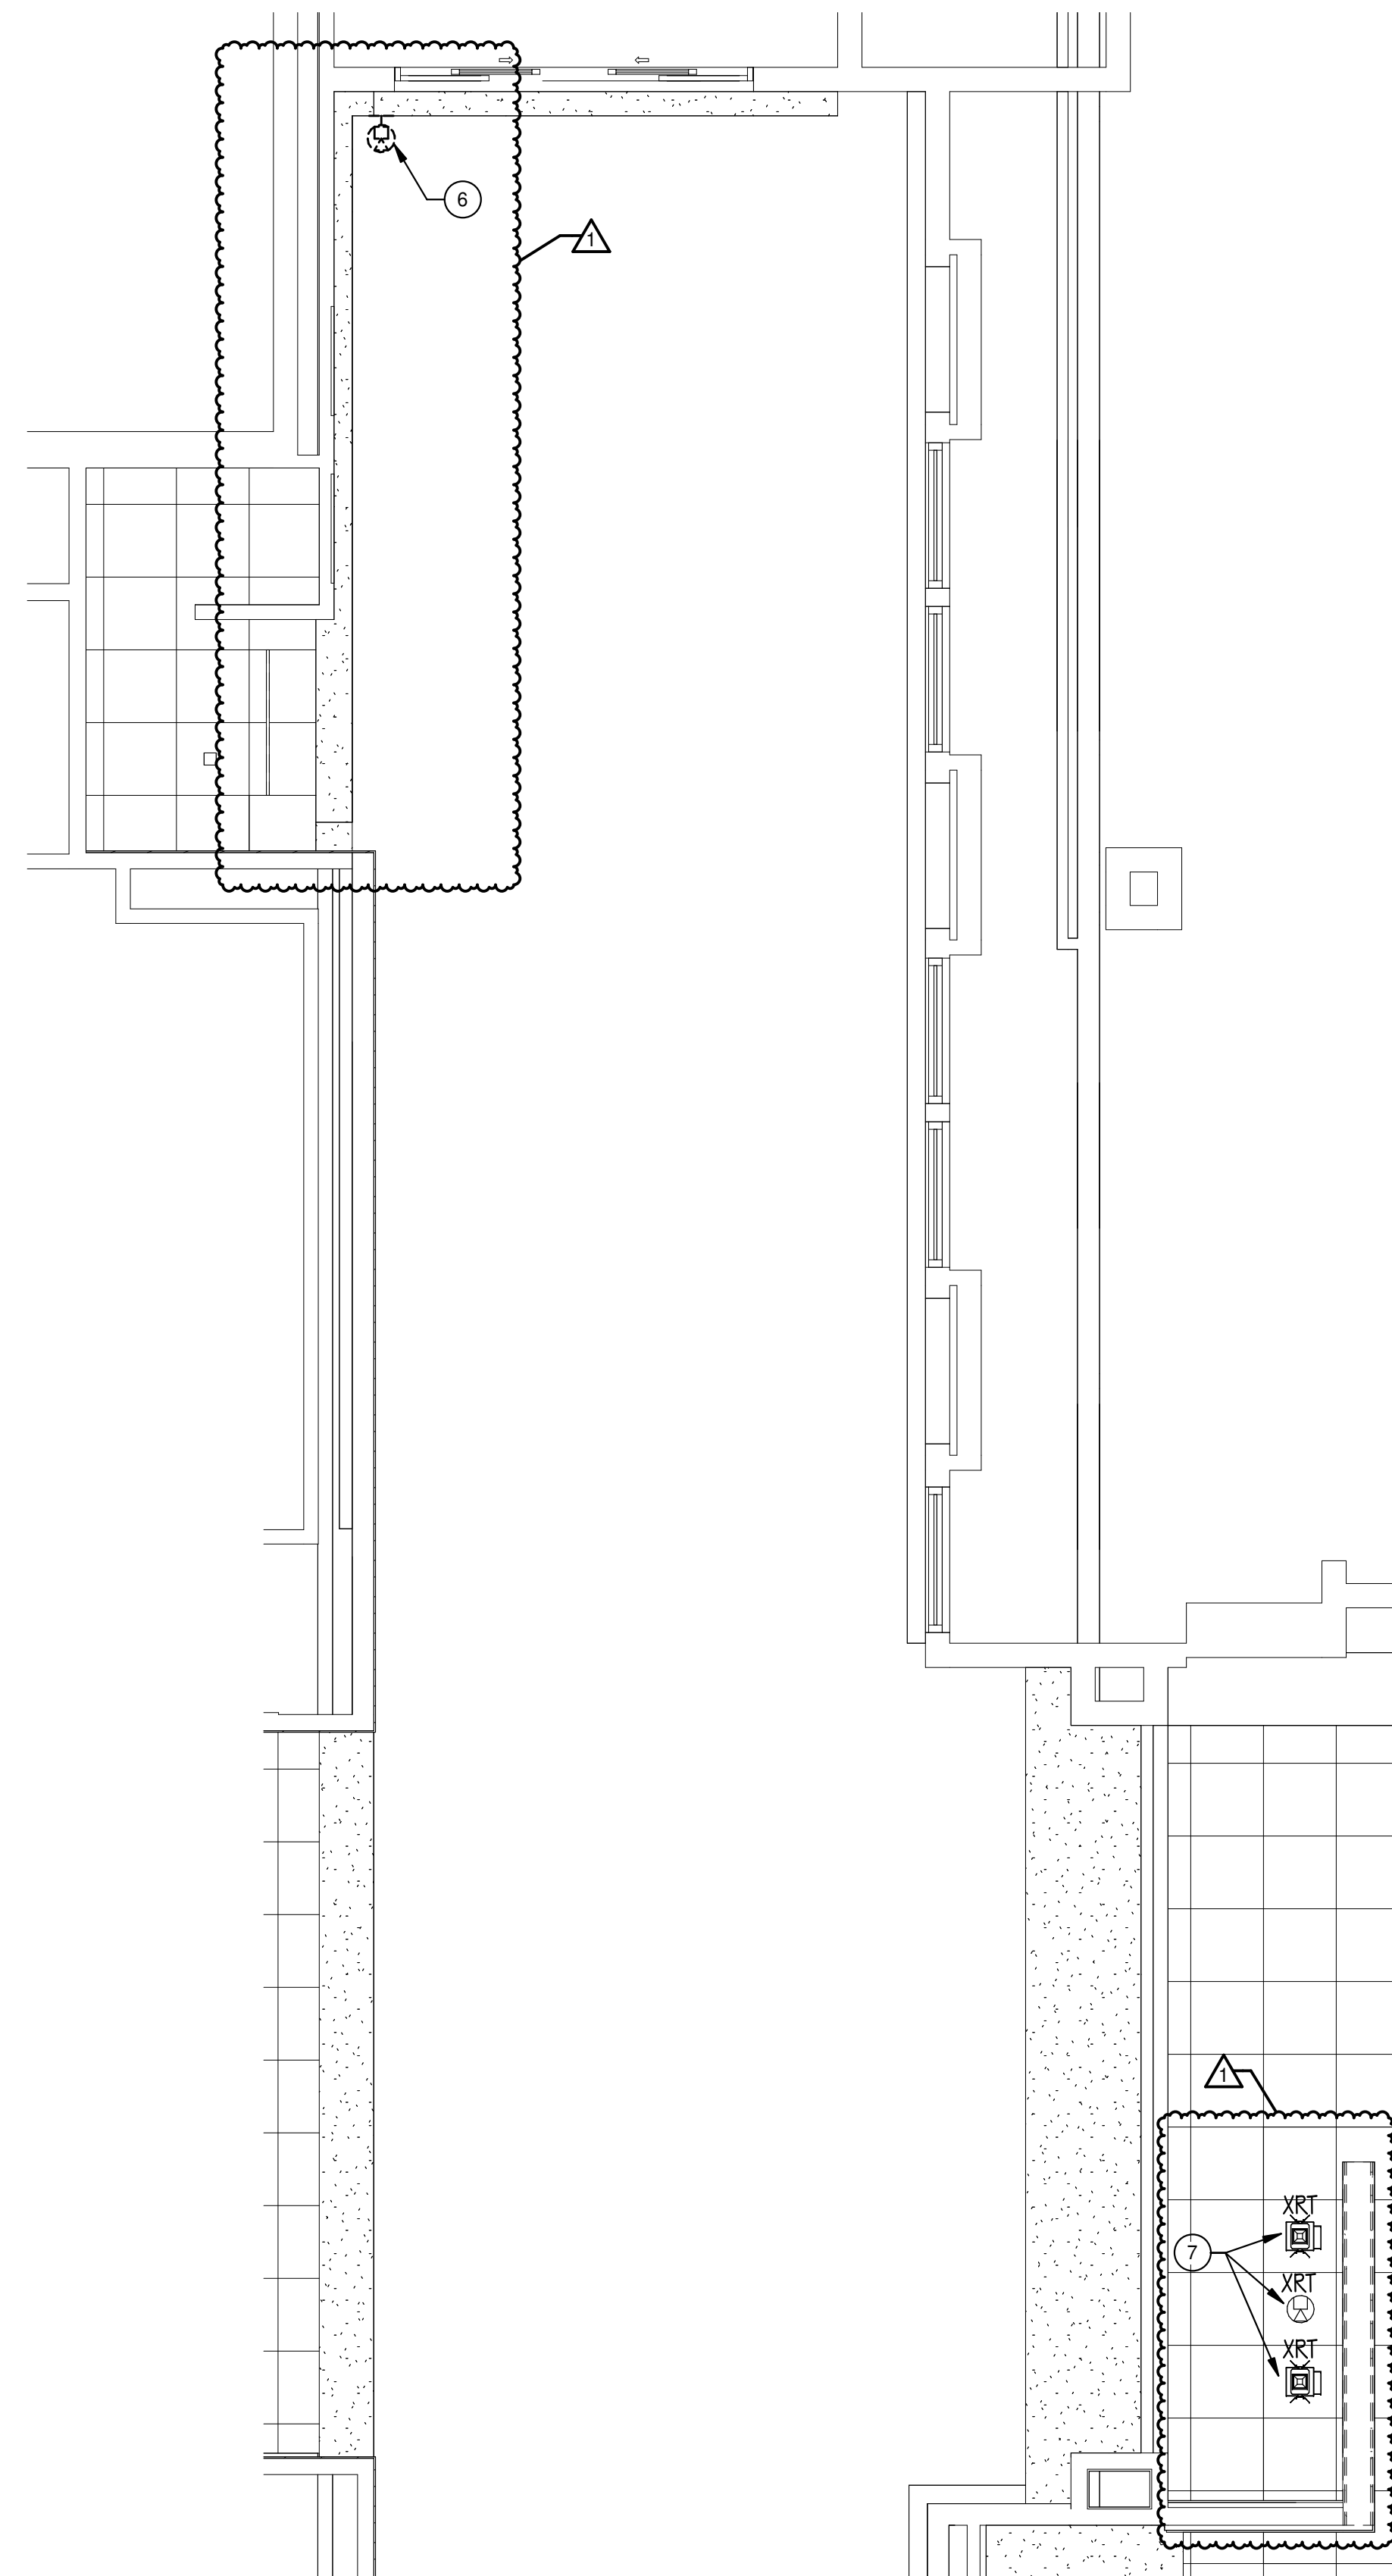

③ FIRST FLOOR POWER PLAN – CAFE
1/4" = 1'-0"

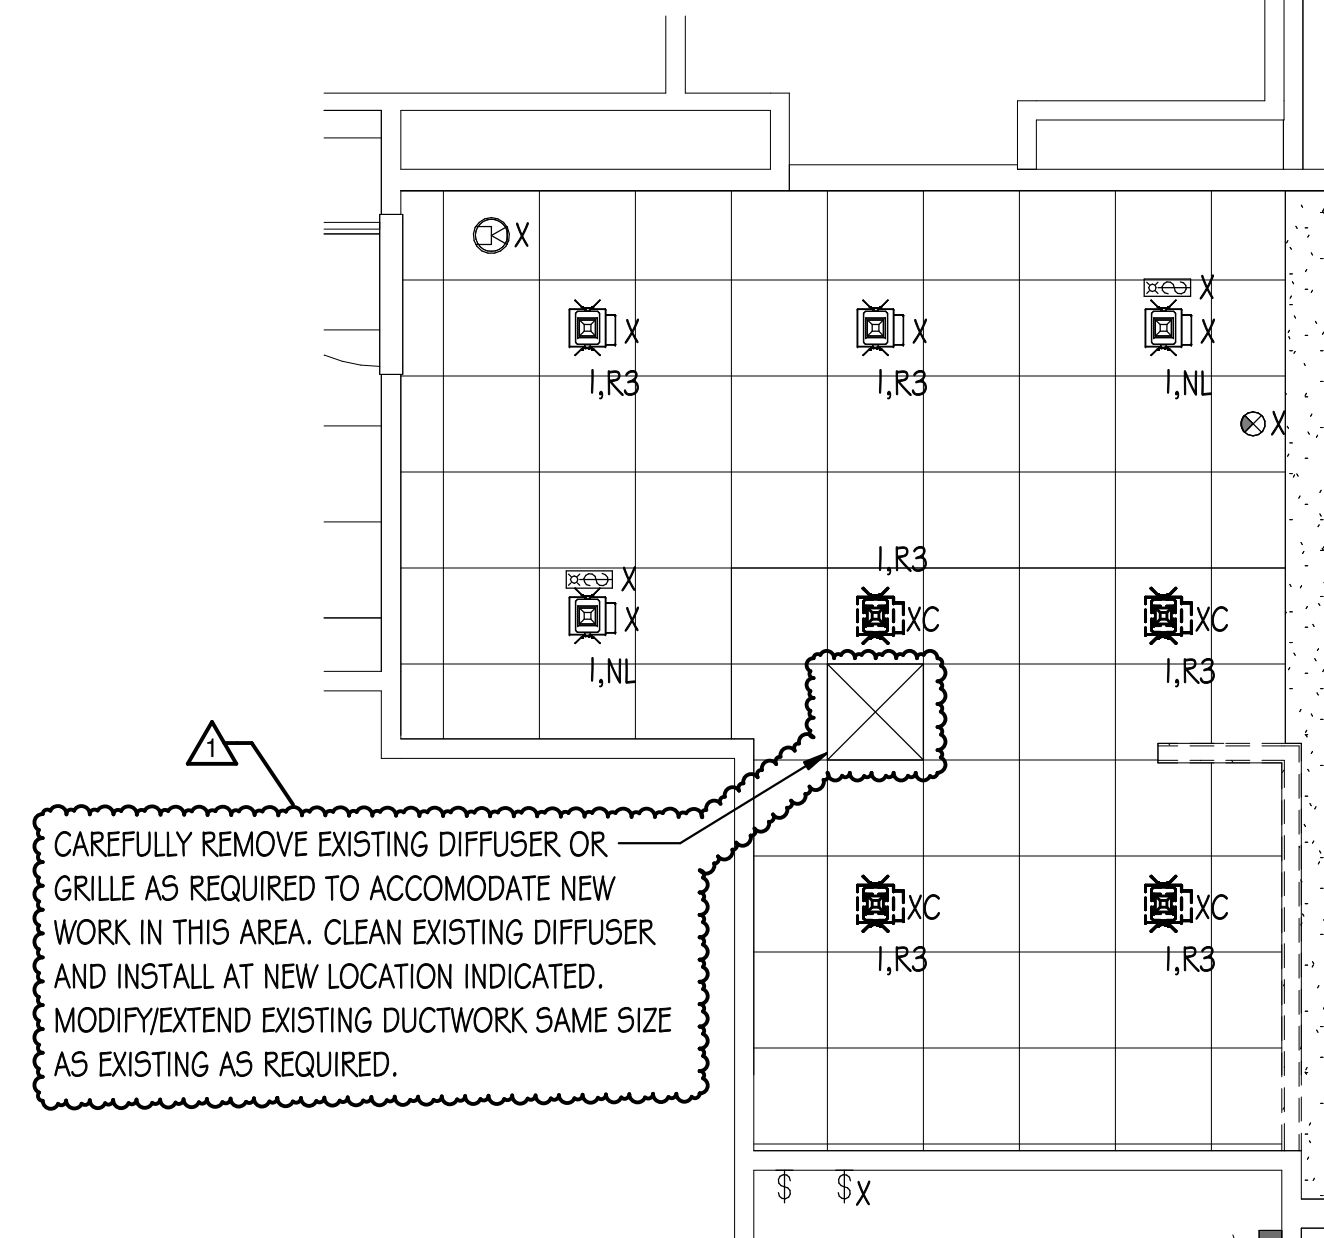

② FIRST FLOOR LIGHTING DEMO PLAN – CAFE
1/4" = 1'-0"

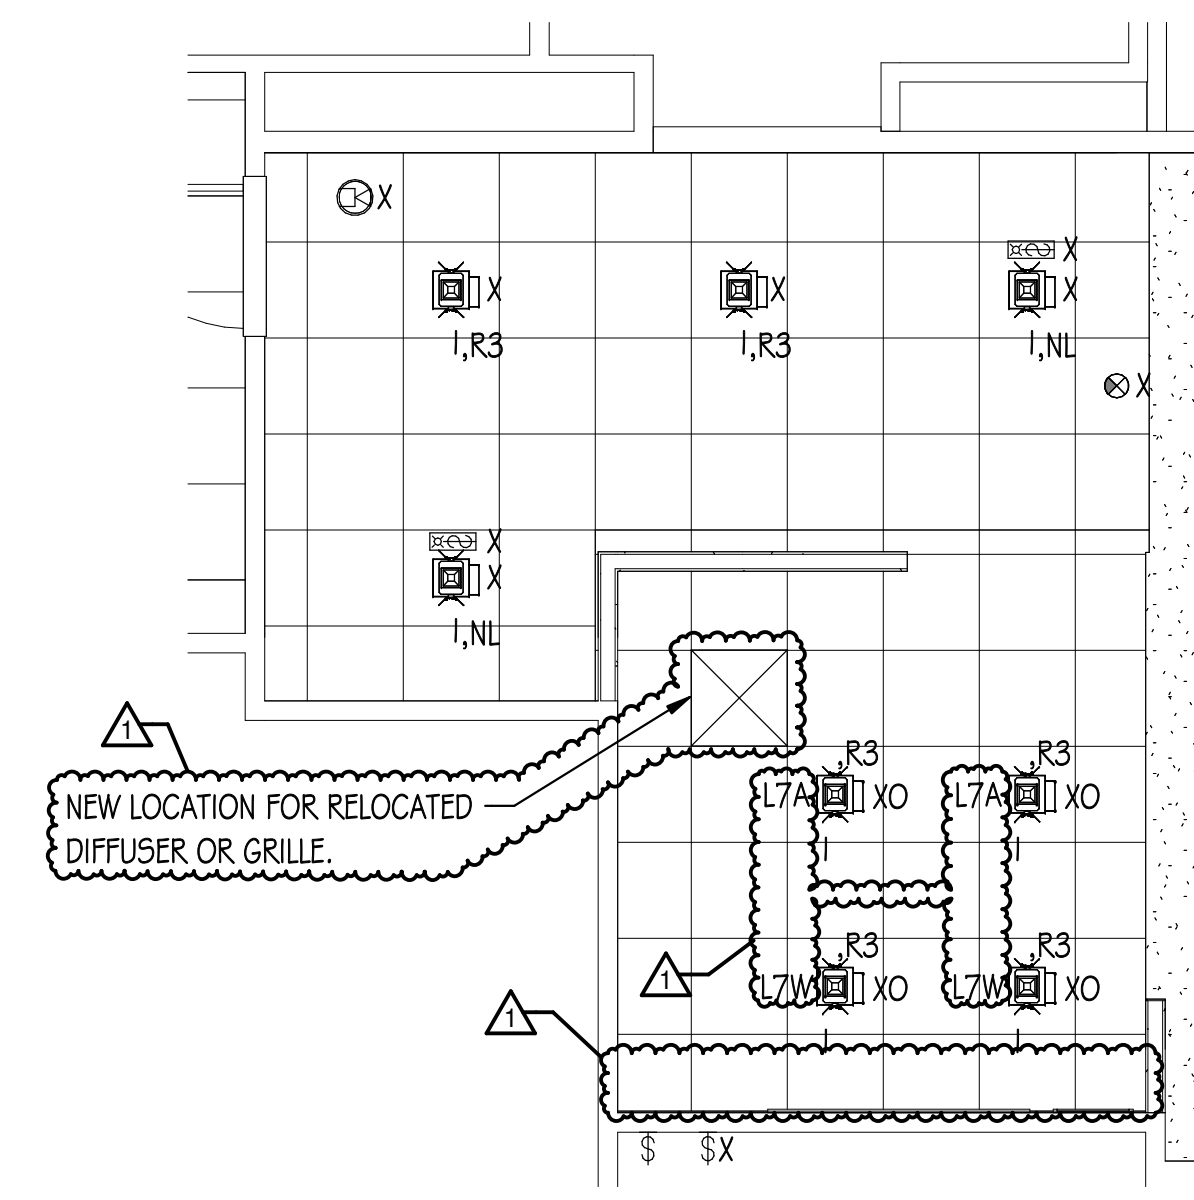

④ FIRST FLOOR LIGHTING PLAN – CAFE
1/4" = 1'-0"

1. PROVIDE GFCI TYPE CIRCUIT BREAKER (REPLACE EXISTING) FOR CIRCUIT SERVING VENDING MACHINES. MATCH EXISTING MANUFACTURER AND AIC RATING (SIEMENS, 65,000, V.I.F.)
2. WALL HEATER TOGGLE SWITCH MOUNTED IN CASE WORK. DISCONNECT AND REINSTALL IN NEW CASEWORK; VERIFY NEW LOCATION WITH ARCHITECT, VERIFY REQUIREMENTS IN FIELD.
3. VERIFY RECEPTACLE LOCATION FOR APPLIANCE WITH ARCHITECT PRIOR TO ROUGH-IN.
4. CONDUCTORS TO BE REUSED FOR NEW SCONCES IN NEARBY LOCATION. REMOVE LIGHT FIXTURES, PULL BACK WIRING, AND REMOVE CONDUIT AS REQUIRED TO ACCOMMODATE RENOVATIONS.
5. RECONNECT LIGHTING AND CONTROLS PREVIOUSLY SERVING REMOVED LIGHTING IN THIS SPACE. EXTEND/MODIFY RACEWAY AND CONDUCTORS AS REQUIRED.
6. DISCONNECT SECURITY CAMERA AND REINSTALL/RECONNECT CAMERA OFFSET FROM ORIGINAL POSITION TO ACCOMMODATE RENOVATIONS. PROVIDE LABOR, MATERIALS, CONDUIT AND BACKBOX AS REQUIRED. REFER TO ARCHITECTURAL PLANS FOR EXACT NEW LOCATION.
7. TEMPORARILY REMOVE THEN REINSTALL SECURITY CAMERA AND DOWNLIGHTS IN SAME LOCATION TO ACCOMMODATE RENOVATIONS.
8. PROVIDE NEMA 1-4-50R RECEPTACLE WITH # 3/8, 1" @ 10G IN 3/4" CONDUIT CONNECTION. REMOVE 2 SPARE CIRCUIT BREAKERS IN SPACES INDICATED AND TURN OVER TO OWNER. PROVIDE 50A/2P CIRCUIT BREAKER MATCHING EXISTING MANUFACTURER AND AIC RATING (SIEMENS, 65,000 V.I.F.) VERIFY NEMA RECEPTACLE TYPE AND CIRCUIT BREAKER SIZE WITH OWNER PRIOR TO EQUIPMENT MANUFACTURER REQUIREMENTS.



Glenview Public Library

Glenview Public Library
1930 Glenview Rd, Glenview, IL 60025

[illegible]

DEMOLITION AND NEW WORK ELECTRICAL AND LIGHTING PLANS

E1.00

25007



1. CONNECT TO EXISTING LIGHTING CIRCUIT AND RELAY PANEL/TIMER CONTROLS SERVING LIGHTING IN THIS AREA; VERIFY EXISTING CONDITIONS IN FIELD.
2. REMOVE FLOOR BOX AND DISCONNECT DATA CABLEING AND CONDUCTORS. DATA CABLEING AND CONDUCTORS BE RECONNECTED AT NEW FLOORBOX LOCATION VERIFY REQUIREMENTS IN FIELD.
3. PROVIDE NEW FLOORBOX SIMILAR TO EXISTING; FOUR-COMPARTMENT FLOOR BOX WITH COVER PLATE AS MANUFACTURED BY LEGRAND, WIREMOLD RFB44 SERIES. PROVIDE ALL INTERNAL BRACKETS AS REQUIRED TO ACCOMMODATE BOTH POWER AND LOW VOLTAGE. PROPOSED ROUTING IS SHOWN. VERIFY FINAL LOCATION WITH ARCHITECT PRIOR TO INSTALLATION. CUT/PATCH FLOOR AND MODIFY/EXTEND UNDERFLOOR (1") CONDUITS AS REQUIRED. RECONNECT DATA CABLEING AND CONDUCTORS SERVING PREVIOUS FLOORBOX LOCATION. PATCH AND REPAIR FLOOR TO MATCH SURROUNDING SURFACE IF NECESSARY. LOCATE AND MARK ANY EXISTING UTILITIES IN AREA BY EMPLOYING SERVICE TO X-RAY THE SLAB. IT SHALL BE THE CONTRACTOR'S RESPONSIBILITY TO REPAIR ANY DAMAGES TO EXISTING UTILITIES DUE TO SAWCUTTING.
4. RECONNECT LIGHTING AND CONTROLS PREVIOUSLY SERVING REMOVED LIGHTING IN THIS SPACE. EXTEND/MODIFY RACWAY AND CONDUCTORS AS REQUIRED.
5. ORIENT THE DOWNLIGHT SUCH THAT THE EMERGENCY BATTERY IS CLOSEST TO THE CEILING ACCESS PANEL.



CIRCUITS INDICATE PANEL 4 I LPB UNLESS NOTED OTHERWISE.
RELAY CIRCUITS INDICATE RELAY PNAEL RP4 I LPB UNLESS NOTED OTHERWISE.

CIRCUITS INDICATE PANEL 21 RPB UNLESS NOTED OTHERWISE.

CIRCUITS INDICATE PANEL 4 LPB UNLESS NOTED OTHERWISE.
RELAY CIRCUITS INDICATE RELAY PNAEL RP4 LPB UNLESS NOTED OTHERWISE.


CIRCUITS INDICATE PANEL 41 LPB UNLESS NOTED OTHERWISE.
RELAY CIRCUITS INDICATE RELAY PNAFL RP41 LPB UNLESS NOTED OTHERWISE

CIRCUITS INDICATE PANEL 2 LRPB UNLESS NOTED OTHERWISE


Glenview Public Library
1930 Glenview Rd, Glenview, IL 60025

[illegible]


25007 **E1.01**

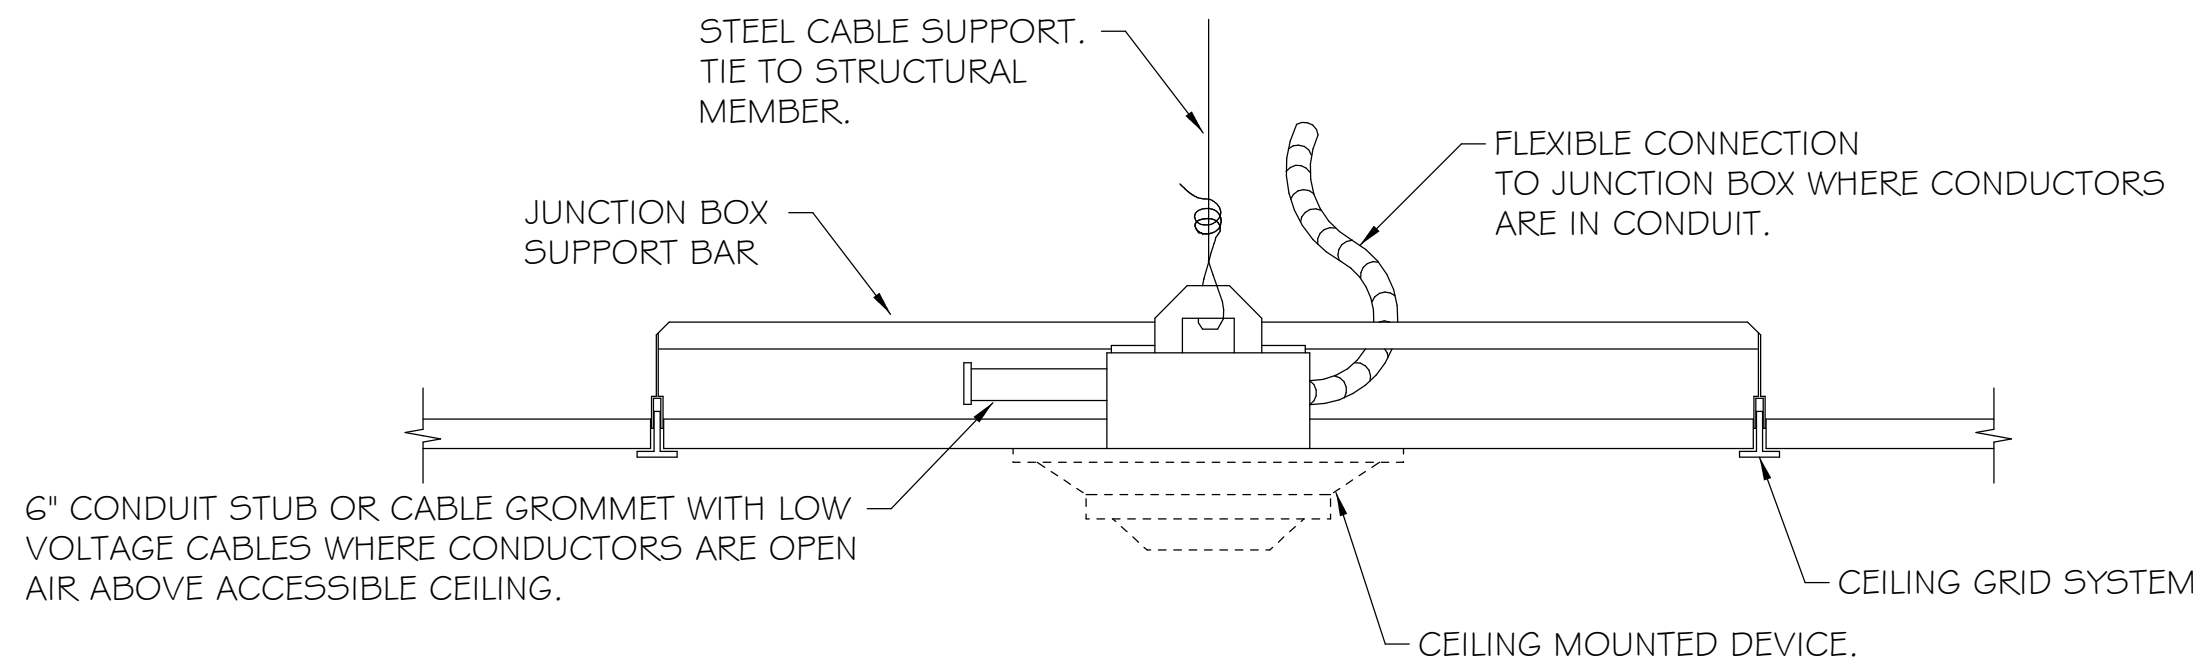


CEILING MOUNTED DEVICE SUPPORT DETAIL
NO SCALE

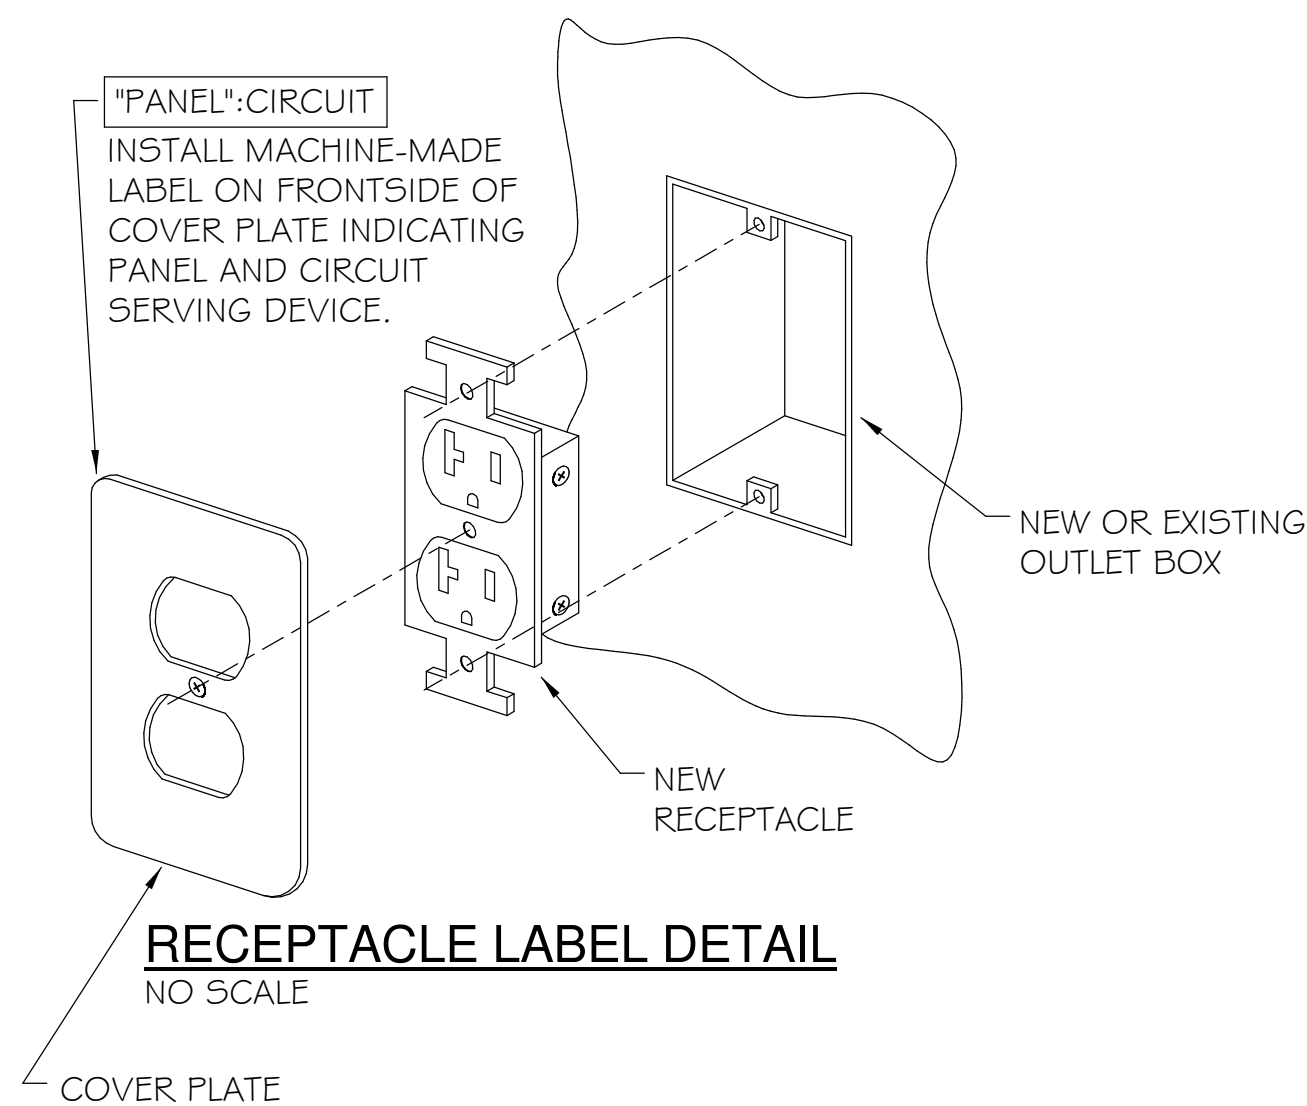

RECEPTACLE LABEL DETAIL
NO SCALE

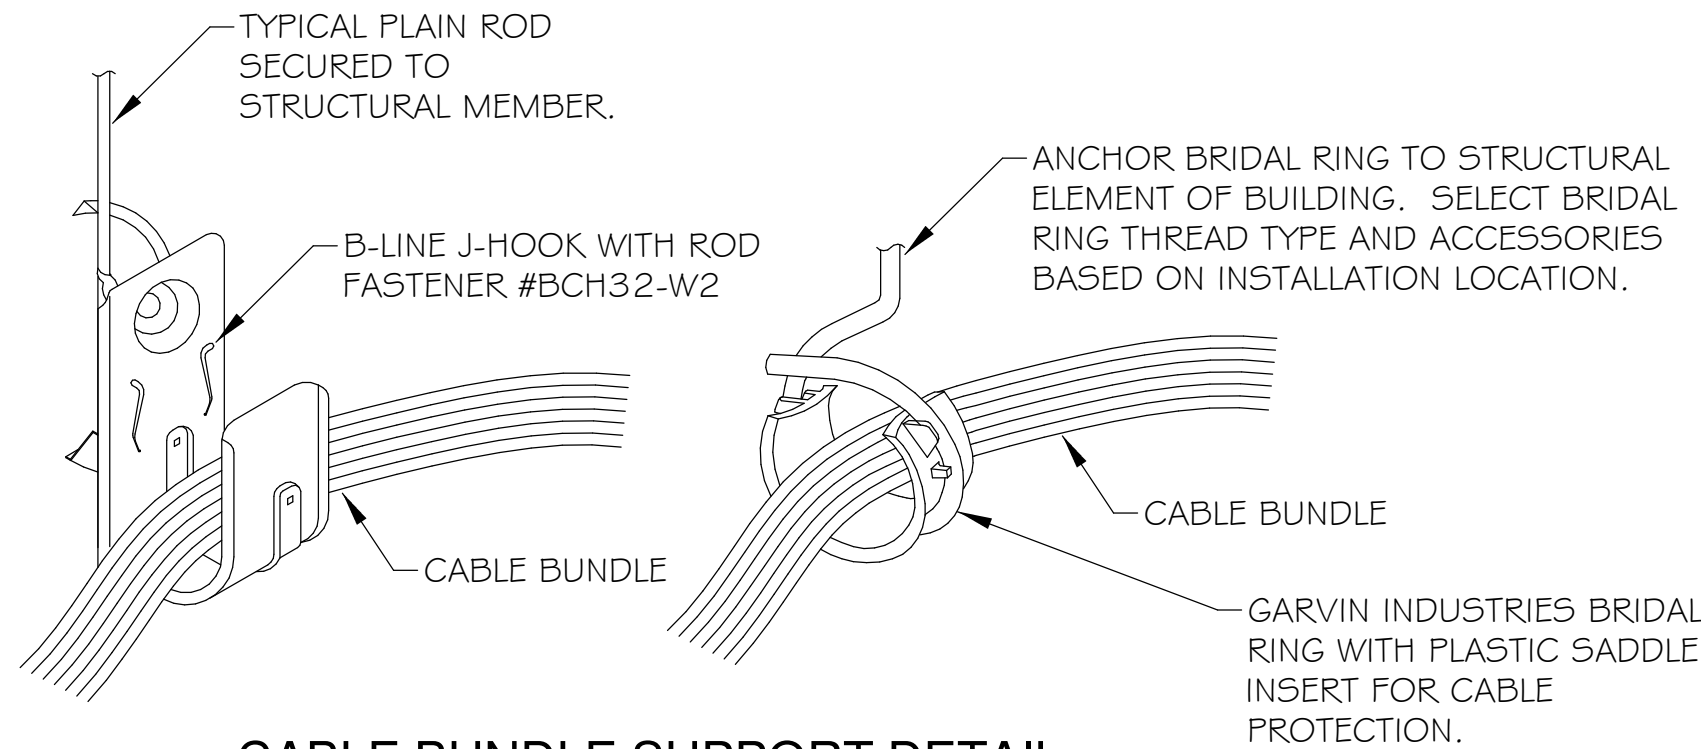

CABLE BUNDLE SUPPORT DETAIL
NO SCALE

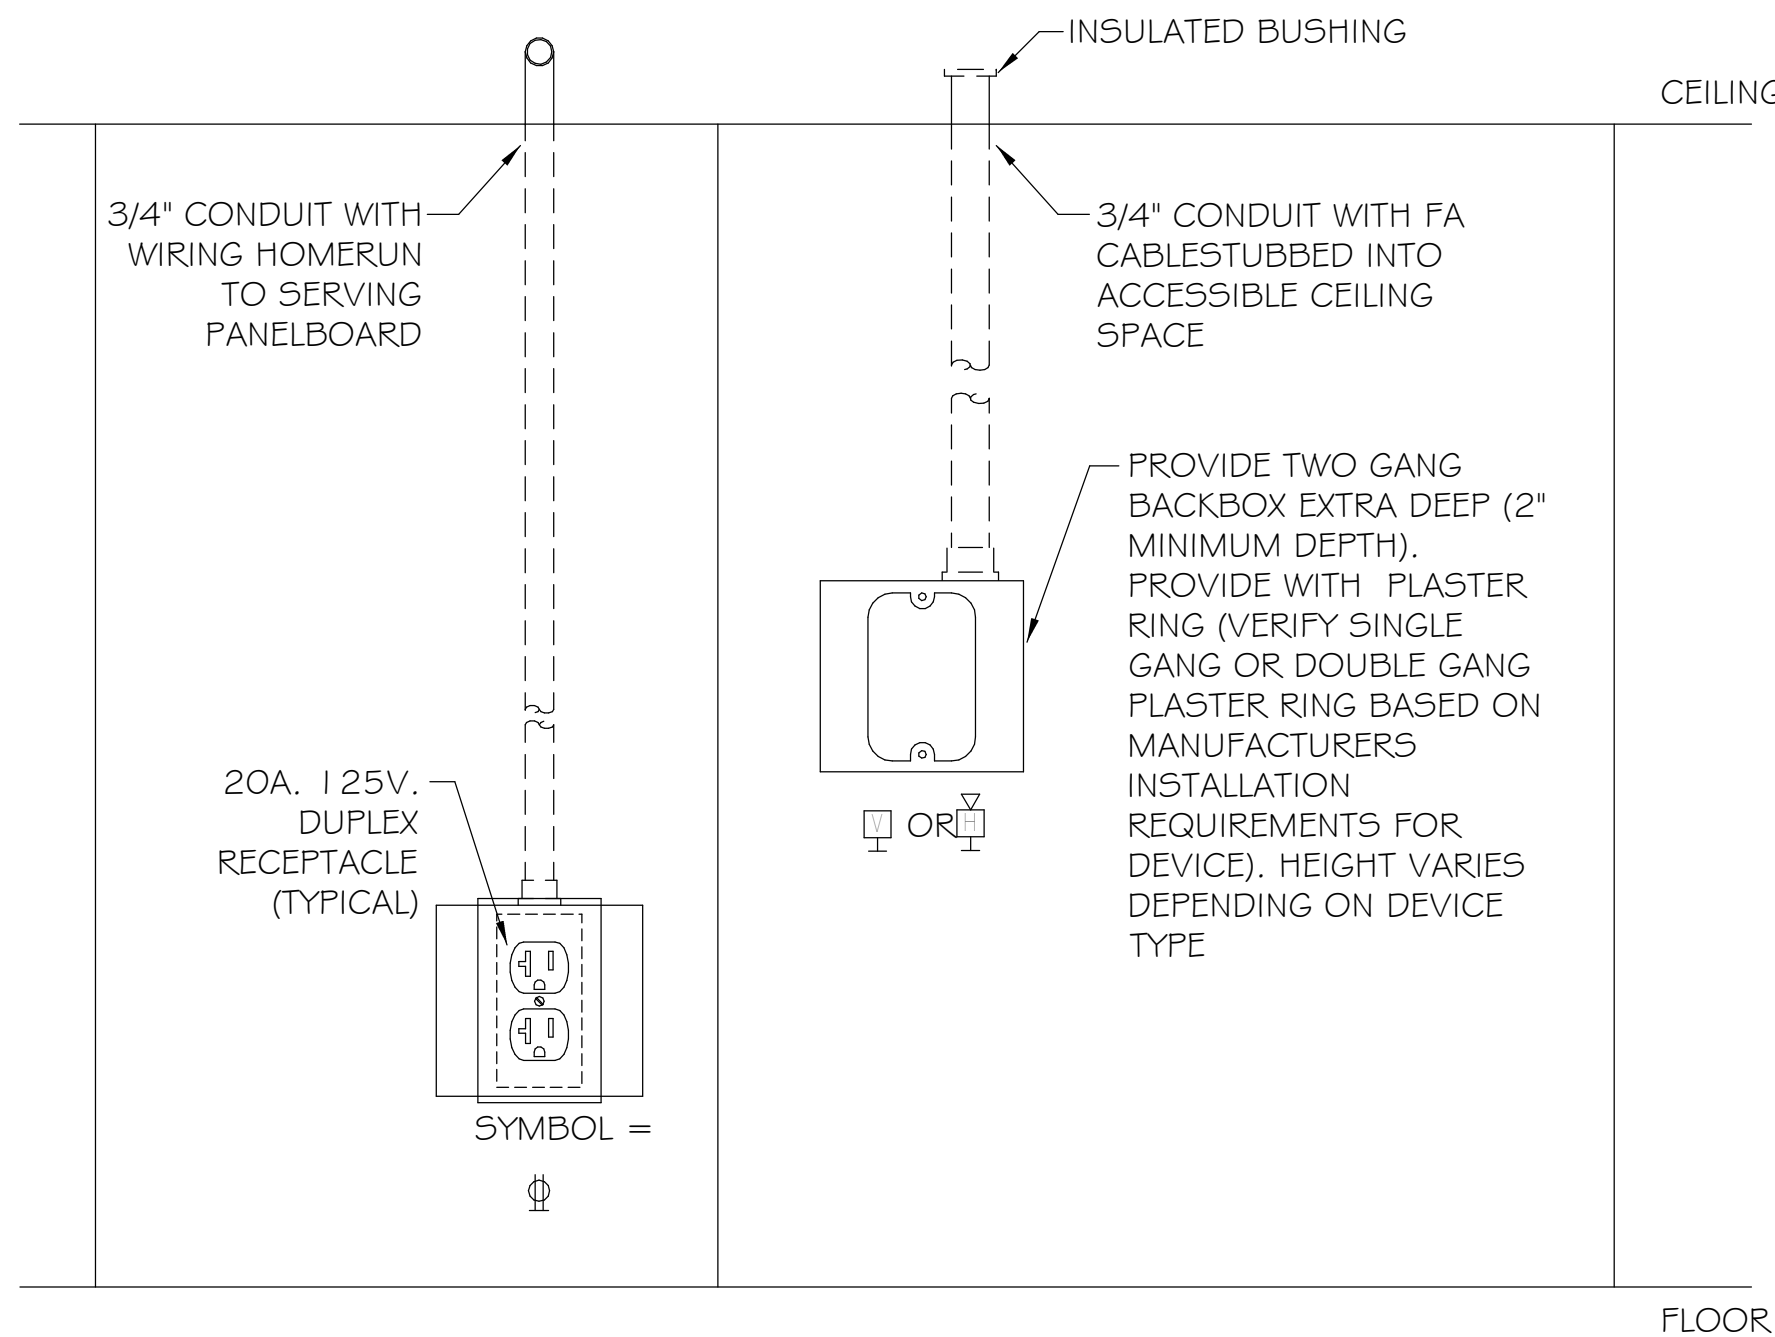

JUNCTION BOX ROUGH-IN DETAIL
NO SCALE

- NOTES:
1. DETAILS ARE FOR REFERENCE ONLY.
 2. NOT ALL DEVICES ARE REQUIRED FOR THIS PROJECT.
 3. PROVIDE TWO GANG BACKBOXES (2" MINIMUM DEPTH) WITH ALL RECEPTACLE OUTLETS.
 4. PROVIDE COVER PLATES FOR ALL NEW DEVICES, MATCH EXISTING BUILDING STANDARD COLOR (IVORY, V.I.F.)

INTERIOR LUMINAIRE SCHEDULE								
TYPE	DESCRIPTION	MOUNTING	LIGHT SOURCE	VOLTAGE	INPUT WATTS	MANUFACTURER & CATALOG NUMBER	ALTERNATE MANUFACTURER	NOTES
L1	4' TUBE, 6' ARM	WALL	LED	277 V	28	ALCON 11703-4-HI-BA-40K-6-2-010	REQUIRES APPROVAL OF ARCHITECT PRIOR TO BID	I
L2	8' TUBE, 18' ARM	WALL	LED	277 V	56	ALCON 11703-8-HI-BA-40K-18-2-010	REQUIRES APPROVAL OF ARCHITECT PRIOR TO BID	I
L3	DECORATIVE GEOMETRIC PENDANT	SUSPENDED	LED	277 V	9.8	EUREKA: MARRO 4228-27	REQUIRES APPROVAL OF ARCHITECT PRIOR TO BID	I
L4	DECORATIVE GEOMETRIC PENDANT	SUSPENDED	LED	277 V	9.8	EUREKA: MARRO 4228-20	REQUIRES APPROVAL OF ARCHITECT PRIOR TO BID	I
L5	DECORATIVE GEOMETRIC PENDANT	SUSPENDED	LED	277 V	9.8	EUREKA: MARRO 4228-13	REQUIRES APPROVAL OF ARCHITECT PRIOR TO BID	I
L6	DECORATIVE SCONCE	WALL	LED	277 V	60	WEST ELM: HENRY SCONCE	REQUIRES APPROVAL OF ARCHITECT PRIOR TO BID	I
L7	4' DOWNLIGHT, MEDIUM WIDE DISTRIBUTION, CLEAR TRIM, SEMI SPECULAR FINISH	RECESSED	LED	277 V	34.4	GOTHAM: IVO IVO45Q-D-35LM-40K-80CRI-MWD-MINI-O-MVOLT-ZT-NCH-SF-P-AR-L55-F	REQUIRES APPROVAL OF ARCHITECT PRIOR TO BID	I
L7A	4' DOWNLIGHT, MEDIUM WIDE DISTRIBUTION, CLEAR TRIM, SEMI SPECULAR FINISH	RECESSED	LED	277 V	15	GOTHAM: IVO IVO45Q-D-15LM-40K-80CRI-MWD-MINI-O-MVOLT-ZT-NCH-SF-P-AR-L55-F	REQUIRES APPROVAL OF ARCHITECT PRIOR TO BID	I
L7e	4' DOWNLIGHT, MEDIUM WIDE DISTRIBUTION, CLEAR TRIM, SEMI SPECULAR FINISH	RECESSED	LED	277 V	34.4	GOTHAM: IVO IVO45Q-D-35LM-40K-80CRI-MWD-MINI-O-MVOLT-ZT-NCH-SF-P-AR-L55-F	REQUIRES APPROVAL OF ARCHITECT PRIOR TO BID	I
L7W	4' DOWNLIGHT, WALLWASH, CLEAR TRIM, SEMI SPECULAR FINISH	RECESSED	LED	277 V	28.8	GOTHAM: IVO IVO45Q-WW-25LM-40K-90CRI-MINI-O-MVOLT-ZT-NCH-SF-LW-AR-L55-F	REQUIRES APPROVAL OF ARCHITECT PRIOR TO BID	I

- NOTES:
1. REFER TO ARCHITECTURAL ELEVATIONS FOR EXACT MOUNTING HEIGHTS.
 2. ORIENT THE DOWNLIGHT SUCH THAT THE EMERGENCY BATTERY IS CLOSEST TO THE CEILING ACCESS PANEL.

- GENERAL NOTES:
- a. CONTRACTOR TO PROVIDE NECESSARY MOUNTING HARDWARE AND LABOR FOR LUMINAIRES.
 - b. PROVIDE OPTIONS AND ACCESSORIES AS REQUIRED TO INSTALL LUMINAIRES IN MOUNTING SURFACES AS SHOWN ON THE PLANS.
 - c. PROVIDE ALL WIRING, CABLING, AND ACCESSORIES REQUIRED FOR PROPER FUNCTIONALITY OF LUMINAIRES UTILIZING OCCUPANCY SENSORS, DAYLIGHT HARVESTING, AND/OR DIMMING.
 - d. INTEGRATE LUMINAIRES INTO EXISTING LIGHTING CONTROLS AND CONNECT TO EXISTING RELAY PANEL; VERIFY REQUIREMENTS IN FIELD.
 - e. SUBSTITUTE LUMINAIRES FROM MANUFACTURERS OTHER THAN THOSE LISTED SHALL BE SUBMITTED FOR PRE-APPROVAL (10) DAYS PRIOR TO SUBMISSION OF BID.
 - f. COLORS AND FINISHES TO BE SELECTED BY THE ARCHITECT.

BIDDING NOTE
SEE DRAWINGS ME1.00 FOR GENERAL NOTES AND ADDITIONAL DETAILS APPLICABLE TO THIS TRADE'S WORK.

MOUNTING HEIGHT NOTE
REFER TO ARCHITECTURAL PLANS FOR ADDITIONAL INFORMATION REGARDING MOUNTING HEIGHTS AND LOCATIONS OF ELECTRICAL DEVICES BEFORE ROUGH-IN.

WHERE CONFLICTS BETWEEN ELECTRICAL & ARCHITECTURAL ELEVATIONS ARISE, CONTRACTOR TO VERIFY WITH ARCHITECT/ENGINEER TEAM PRIOR TO ROUGH-IN.

NOTE
INCIDENTAL WORK MAY ALSO BE NECESSARY DUE TO CHANGES AFFECTING, SITE WORK, ELECTRICAL, OR OTHER SYSTEMS. SUCH INCIDENTAL WORK IS ALSO PART OF THIS CONTRACT. INSPECT THOSE AREAS, COORDINATE WITH OTHER TRADES, AND ASCERTAIN WORK NEEDED, AND DO THAT WORK IN ACCORD WITH THE CONTRACT REQUIREMENTS, AT NO ADDITIONAL COST. THE REMOVAL & REINSTALLATION OF EXISTING WORK TO ACCOMMODATE CHANGES TO EXISTING, OR INSTALLATION OF, ELECTRICAL, OTHER SYSTEMS IS ALSO PART OF THIS CONTRACT.

NOTE
CONTRACTOR SHALL BE RESPONSIBLE FOR THE SUPPORT OF LIGHT FIXTURES WHERE ACCESSIBLE CEILINGS ARE BEING REMOVED AND REPLACED. ALL EXISTING LIGHT FIXTURES ARE NOT SUPPORTED INDEPENDENTLY OF THE CEILING GRID. CONTRACTOR IS RESPONSIBLE FOR SUPPORTING EXISTING LIGHT FIXTURES IN PLACE WHERE MARKED "XRT". AT CONCLUSION OF PROJECT ALL EXISTING AND NEW LIGHT FIXTURES IN AREAS OF CEILING REPLACEMENT SHALL BE SUPPORTED INDEPENDENTLY OF THE CEILING GRID WITH SUPPORT WIRES CONNECTED TO STRUCTURAL ELEMENTS OF THE BUILDING AT OPPOSITE CORNERS.

NOTE
EXISTING CONDITIONS WERE OBTAINED FROM EXISTING AS-BUILT DRAWINGS AND CURSORY FIELD OBSERVATION. THIS CONTRACTOR SHALL IDENTIFY ANY DISCREPANCIES IN THE FIELD AND REPORT THEM TO THE ENGINEER.

NO	ISSUE	DATE
1	Bid Set	06/16/2025
	Addendum 1	06/30/2025

ELECTRICAL NOTES, DETAILS, AND SCHEDULES

